

PREPARED FOR:
**EL MONTE
UNION HIGH
SCHOOL
DISTRICT**

SITE:
**ARROYO
HIGH SCHOOL**

4921 CEDAR AVENUE
EL MONTE, CA 91732

**AS-BUILT
PROJECT NO. 5231**

REVISIONS:

DATE: DESCRIPTION:

DRAWN BY:

GERARDO MORALES

DATE:

10/9/12

SCALE:

AS SHOWN

SIZE:

11x17

TITLE:

**MDF
WIRELESS
ACCESS POINT
PLAN**

*PROPERTY OF E.O. O'NEILL & SONS, INC. © 2012

SHEET #:

T2

2 OF 29





MDF - WIRELESS ACCESS POINT PLAN

SCALE: 3/32" = 1'-0"

LEGEND

⊗ WIRELESS ACCESS POINT

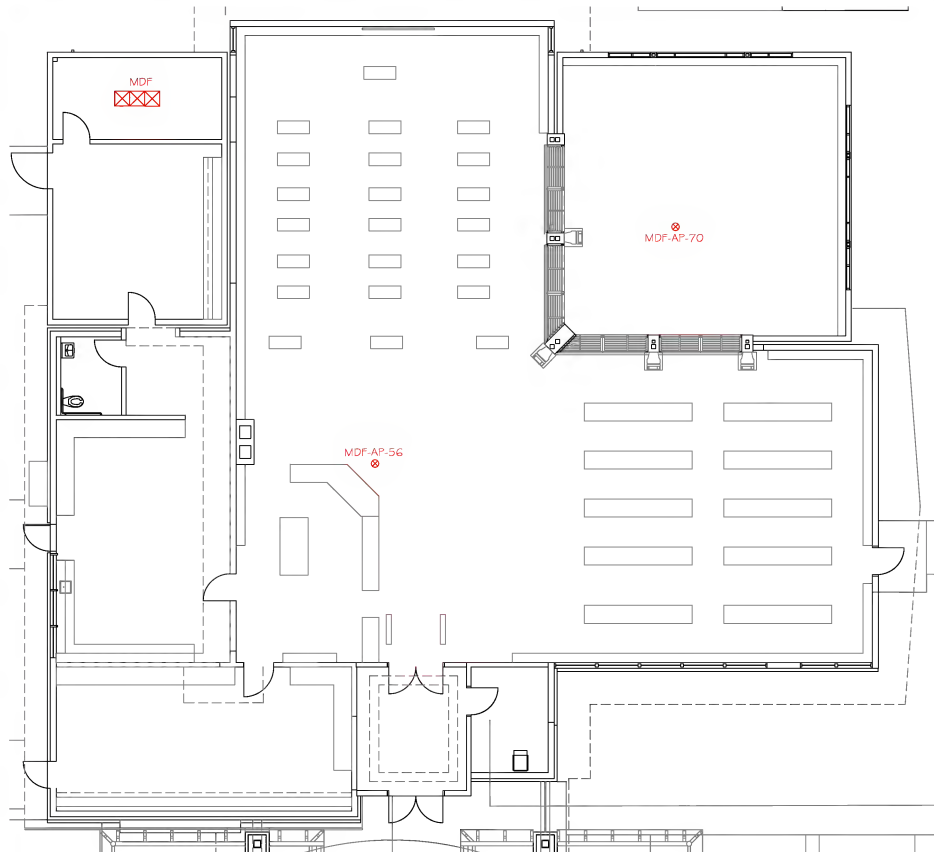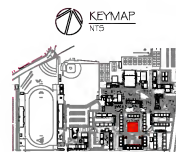

PREPARED FOR:
**EL MONTE
UNION HIGH
SCHOOL
DISTRICT**

SITE:
**ARROYO
HIGH SCHOOL**

4921 CEDAR AVENUE
EL MONTE, CA 91732

**AS-BUILT
PROJECT NO. 5231**





IDF-A - WIRELESS ACCESS POINT PLAN

SCALE: 1/16" = 1'-0"

LEGEND

⊗ WIRELESS ACCESS POINT

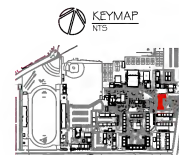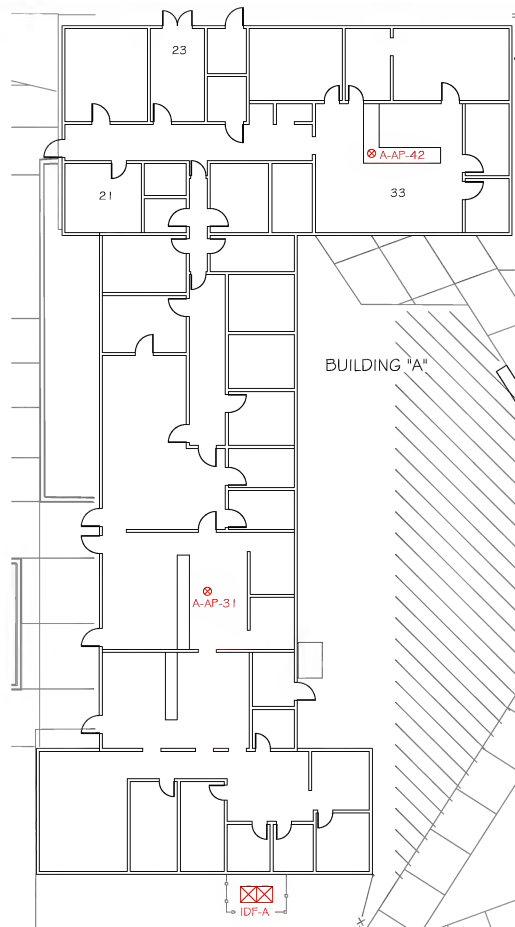

REVISIONS:

DATE DESCRIPTION

DRAWN BY:

GERARDO MORALES

DATE:

10/9/12

SCALE:

AS SHOWN

SIZE:

11x17

TITLE:

**IDF-A
WIRELESS
ACCESS POINT
PLAN**

PROPERTY OF EASY NETWORKS
NOT TO BE USED FOR REPRODUCTION

SHEET #:


T3

3 OF 29

IDF-B


X

BUILDING "P"

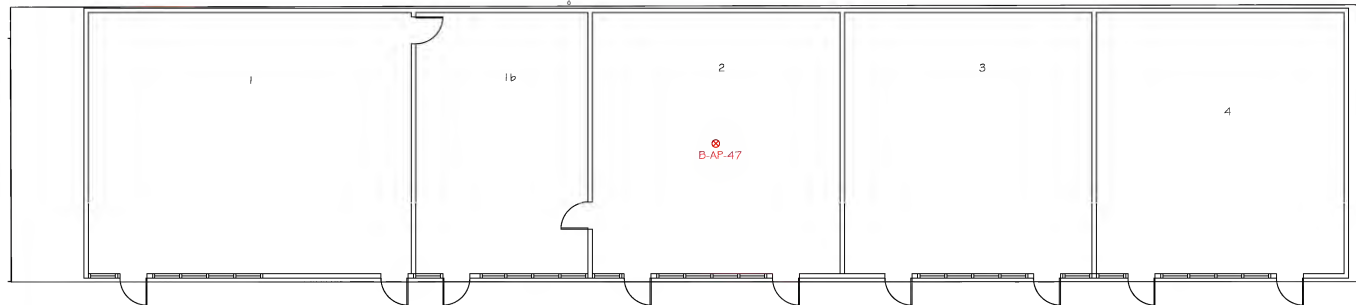

IDF-B - WIRELESS ACCESS POINT PLAN

SCALE: 3/32" = 1'-0"

LEGEND

 WIRELESS ACCESS POINT

EASYNETWORKS
 CABLE

3500 SUTLEY WAY
 RIVERSIDE, CA 92503
 OFFICE: 951-505-1919
 FAX: 951-505-1920
 E-MAIL: EASY@EASYNETWORKS.COM

PREPARED FOR:
**EL MONTE
 UNION HIGH
 SCHOOL
 DISTRICT**

SITE:
**ARROYO
 HIGH SCHOOL**

4921 CEDAR AVENUE
 EL MONTE, CA 91732

**AS-BUILT
 PROJECT NO. 5231**

REVISIONS:

DATE	DESCRIPTION

DRAWN BY:

GERARDO MORALES

DATE:

10/9/12

SCALE:

AS SHOWN

SIZE:

11x17

TITLE:


**IDF-B
 WIRELESS
 ACCESS POINT
 PLAN**

* PROPERTY OF EASY NETWORKS *
 * NOT TO BE USED FOR REPRODUCTION *

SHEET #:

T4

4 OF 29

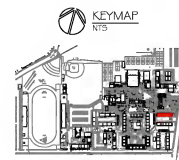

PREPARED FOR:
**EL MONTE
UNION HIGH
SCHOOL
DISTRICT**

SITE:
**ARROYO
HIGH SCHOOL**

4921 CEDAR AVENUE
EL MONTE, CA 91732

**AS-BUILT
PROJECT NO. 5231**

REVISIONS:

DATE DESCRIPTION:

DRAWN BY:

GERARDO MORALES

DATE:

10/9/12

SCALE:

AS SHOWN

SIZE:

11x17

TITLE:

**IDF-C
WIRELESS
ACCESS POINT
PLAN**


* PROPERTY OF EASY NETWORKS
* NOT TO BE USED FOR REPRODUCTION

SHEET #:

T5

5 OF 29

BUILDING "P"

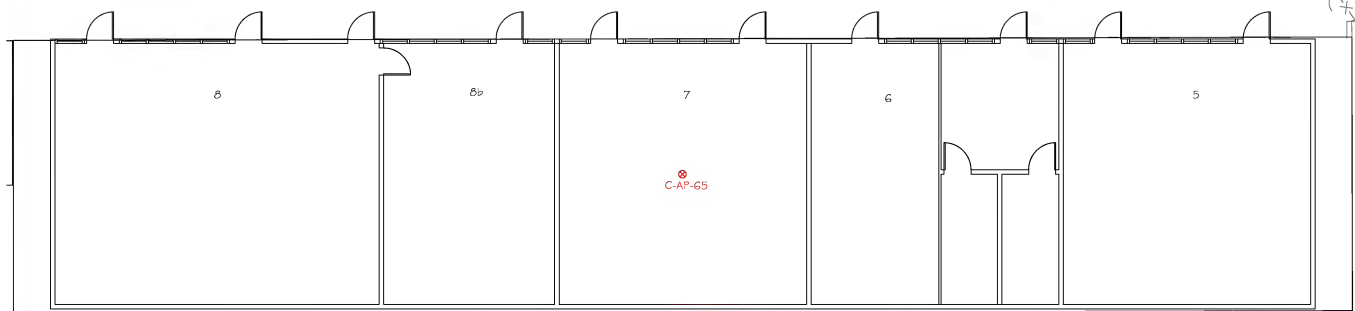


IDF-C - WIRELESS ACCESS POINT PLAN

SCALE: 3/32" = 1'-0"

LEGEND

 WIRELESS ACCESS POINT


IDF-C

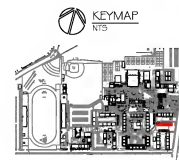

PREPARED FOR:
**EL MONTE
UNION HIGH
SCHOOL
DISTRICT**

SITE:
**ARROYO
HIGH SCHOOL**

4921 CEDAR AVENUE
EL MONTE, CA 91732

**AS-BUILT
PROJECT NO. 5231**

REVISIONS:

DATE	DESCRIPTION

DRAWN BY:

GERARDO MORALES

DATE:

10/9/12

SCALE:

AS SHOWN

SIZE:

11x17

TITLE:

**IDF-D
WIRELESS
ACCESS POINT
PLAN**

• PROPERTY OF EASY NETWORKS •
• NOT TO BE USED FOR REPRODUCTION •

SHEET #:

T6

6 OF 29

BUILDING "B"

D-AP-50



D-AP-52



14

13

12

11

10



IDF-D - WIRELESS ACCESS POINT PLAN


SCALE: 3/32" = 1'-0"

IDF-D



LEGEND

WIRELESS ACCESS POINT

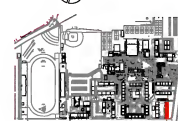

PREPARED FOR:
**EL MONTE
UNION HIGH
SCHOOL
DISTRICT**

SITE:
**ARROYO
HIGH SCHOOL**

4921 CEDAR AVENUE
EL MONTE, CA 91732

**AS-BUILT
PROJECT NO. 5231**

REVISIONS:

DATE	DESCRIPTION

DRAWN BY:

GERARDO MORALES

DATE:

10/9/12

SCALE:

AS SHOWN

SIZE:

11x17

TITLE:

**IDF-E
WIRELESS
ACCESS POINT
PLAN**


* PROPERTY OF EASY NETWORKS *
* NOT TO BE USED FOR REPRODUCTION *

SHEET #:

T7

7 OF 29

BUILDING "B"

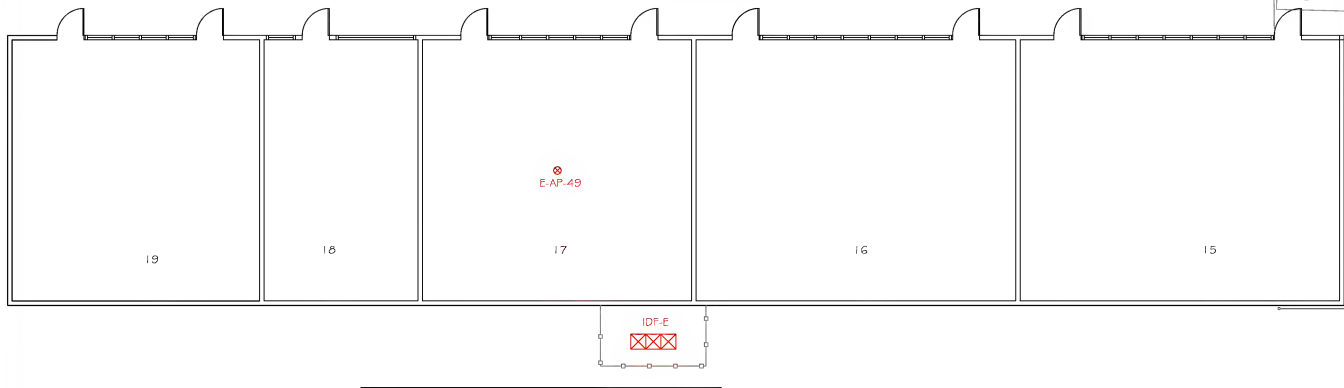


IDF-E - WIRELESS ACCESS POINT PLAN

SCALE: 3/32" = 1'-0"

LEGEND

⊗ WIRELESS ACCESS POINT

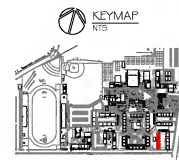

PREPARED FOR:
**EL MONTE
UNION HIGH
SCHOOL
DISTRICT**

SITE:
**ARROYO
HIGH SCHOOL**

4921 CEDAR AVENUE
EL MONTE, CA 91732

**AS-BUILT
PROJECT NO. 5231**

REVISIONS:

DATE	DESCRIPTION

DRAWN BY:

GERARDO MORALES

DATE:

10/9/12

SCALE:

AS SHOWN

SIZE:

11 x 17

TITLE:

**IDF-F
WIRELESS
ACCESS POINT
PLAN**


* PROPERTY OF EASY NETWORKS
* NOT TO BE USED FOR REPRODUCTION

SHEET #:

T8

8 OF 29

BUILDING "C"

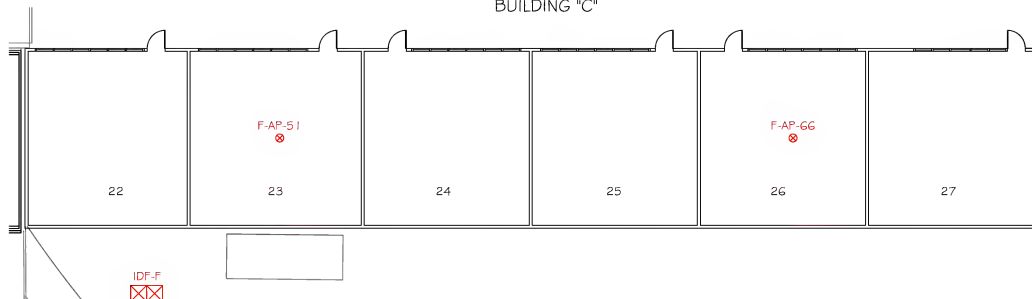


IDF-F - WIRELESS ACCESS POINT PLAN

SCALE: 1/16" = 1'-0"

LEGEND

⊗ WIRELESS ACCESS POINT

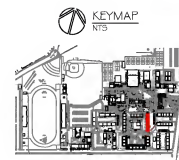

PREPARED FOR:
**EL MONTE
UNION HIGH
SCHOOL
DISTRICT**

SITE:
**ARROYO
HIGH SCHOOL**

4921 CEDAR AVENUE
EL MONTE, CA 91732

**AS-BUILT
PROJECT NO. 5231**

REVISIONS:

DATE: DESCRIPTION:

DRAWN BY:

GERARDO MORALES

DATE:

10/9/12

SCALE:

AS SHOWN

SIZE:

11x17

TITLE:

**IDF-G
WIRELESS
ACCESS POINT
PLAN**

* PROPERTY OF E.O. NETWORKS *
* NOT TO BE REPRODUCED * *


SHEET #:

T9

9 OF 29

IDF-G
⊗

BUILDING "N"

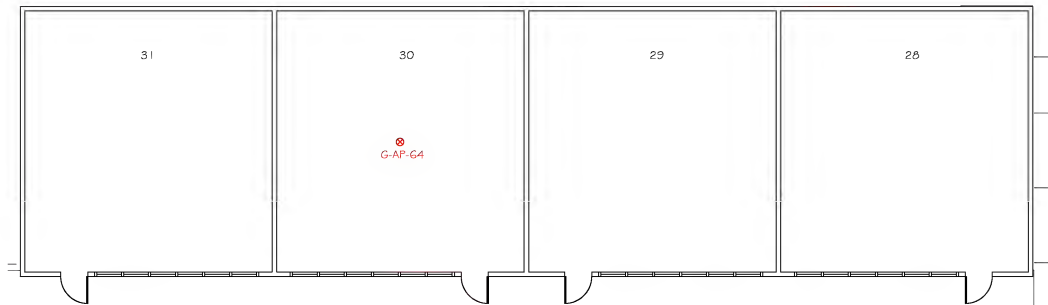


IDF-G - WIRELESS ACCESS POINT PLAN

SCALE: 1/16" = 1'-0"

LEGEND

⊗ WIRELESS ACCESS POINT

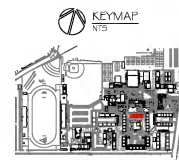

PREPARED FOR:
**EL MONTE
UNION HIGH
SCHOOL
DISTRICT**

SITE:
**ARROYO
HIGH SCHOOL**

4921 CEDAR AVENUE
EL MONTE, CA 91732

**AS-BUILT
PROJECT NO. 5231**

REVISIONS:

DATE DESCRIPTION:

DRAWN BY:

GERARDO MORALES

DATE: 10/9/12

SCALE: AS SHOWN

SIZE: 11x17

TITLE:

**IDF-H
WIRELESS
ACCESS POINT
PLAN**


*** PROPERTY OF EASY NETWORKS *
* FOR USE BY OUR CUSTOMERS ONLY ***

SHEET #:

T10

10 OF 29


BUILDING "D"

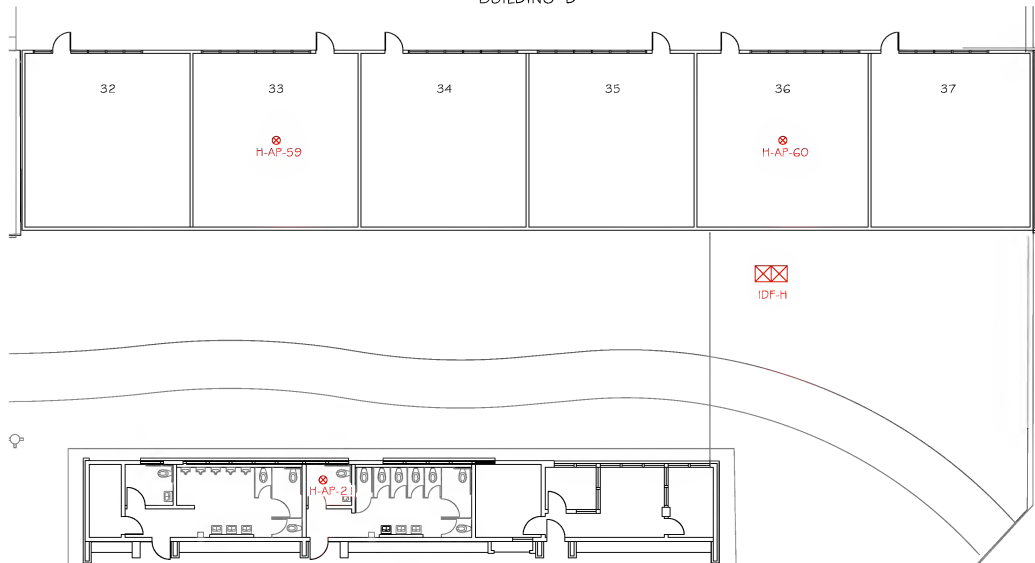

IDF-H - WIRELESS ACCESS POINT PLAN
SCALE: 1/16" = 1'-0"

LEGEND

WIRELESS ACCESS POINT

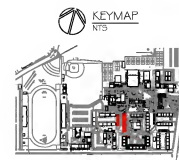


PREPARED FOR:
**EL MONTE
UNION HIGH
SCHOOL
DISTRICT**

SITE:
**ARROYO
HIGH SCHOOL**

4921 CEDAR AVENUE
EL MONTE, CA 91732

**AS-BUILT
PROJECT NO. 5231**

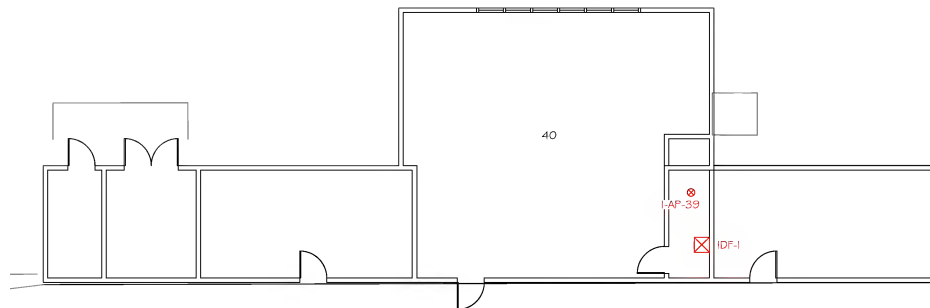

IDF-1 - WIRELESS ACCESS POINT PLAN

SCALE: 3/32" = 1'-0"

LEGEND

⊗ WIRELESS ACCESS POINT

REVISIONS:

Δ DATE: DESCRIPTION:

DRAWN BY:

GERARDO MORALES

DATE:

10/9/12

SCALE:

AS SHOWN

SIZE:

11x17

TITLE:


**IDF-1
WIRELESS
ACCESS POINT
PLAN**

* PROPERTY OF E.O. OF NETWORKS *
* NOT TO BE REPRODUCED *
* WITHOUT WRITTEN PERMISSION *


SHEET #:

T 11

11 OF 29

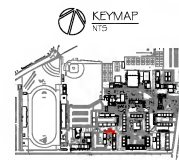


BUILDING "F"

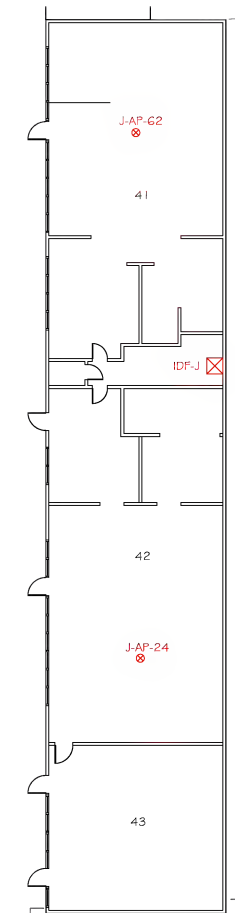

IDF-J - WIRELESS ACCESS POINT PLAN
SCALE: 1/16" = 1'-0"

LEGEND

⊗ WIRELESS ACCESS POINT

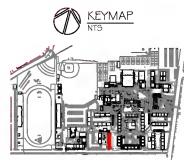

EASYNETWORKS
CABLING

3500 SUTCLIFF WAY
RIVERSIDE, CA 92503
OFFICE: 951-502-8119
FAX: 951-502-8105
ST. LC: 1-800-770

PREPARED FOR:
**EL MONTE
UNION HIGH
SCHOOL
DISTRICT**

SITE:
**ARROYO
HIGH SCHOOL**

4921 CEDAR AVENUE
EL MONTE, CA 91732

**AS-BUILT
PROJECT NO. 5231**

REVISIONS:

Δ	DATE	DESCRIPTION

DRAWN BY:

GERARDO MORALES

DATE:

10/9/12

SCALE:

AS SHOWN

SIZE:

11x17

TITLE:

**IDF-J
WIRELESS
ACCESS POINT
PLAN**

* PROPERTY OF EASY NETWORKS *
* NOT TO BE USED BY OTHERS WITHOUT PERMISSION *

SHEET #:

T12

12 OF 29

PREPARED FOR:
**EL MONTE
UNION HIGH
SCHOOL
DISTRICT**

SITE:
**ARROYO
HIGH SCHOOL**

4921 CEDAR AVENUE
EL MONTE, CA 91732

**AS-BUILT
PROJECT NO. 5231**

BUILDING "F"

IDF-K


45

K-AP-46





44



IDF-K - WIRELESS ACCESS POINT PLAN
SCALE: 3/32" = 1'-0"

LEGEND

 WIRELESS ACCESS POINT

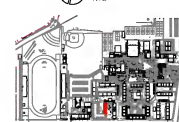

REVISIONS:

 DATE: DESCRIPTION:

DRAWN BY:

GERARDO MORALES

DATE:

10/9/12

SCALE:

AS SHOWN

SIZE:

11 x 17

TITLE:


**IDF-K
WIRELESS
ACCESS POINT
PLAN**

* PROPERTY OF EASY NETWORKS *
* NOT TO BE USED BY OTHER NETWORKS ONLY *

SHEET #:

T13

13 OF 29

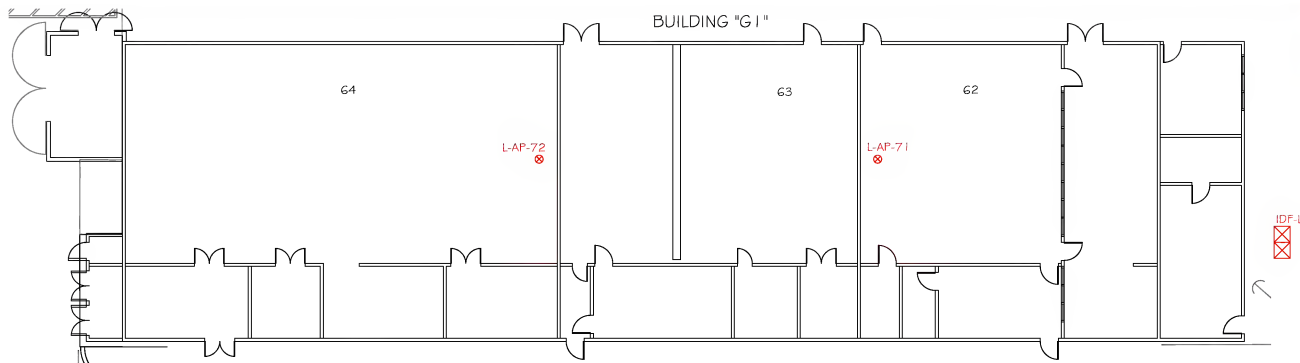

IDF- L - WIRELESS ACCESS POINT PLAN

SCALE: 1/16" = 1'-0"

LEGEND

⊗ WIRELESS ACCESS POINT

EASYNETWORKS
CABLING

3500 SHUTTERWAY
RIVERSIDE, CA 92503
OFFICE: 951-505-9119
FAX: 951-505-9120
ST. LC: 1-800-770

PREPARED FOR:
**EL MONTE
UNION HIGH
SCHOOL
DISTRICT**

SITE:
**ARROYO
HIGH SCHOOL**

4921 CEDAR AVENUE
EL MONTE, CA 91732

AS-BUILT
PROJECT NO. 5231

REVISIONS:

Δ DATE: DESCRIPTION:

DRAWN BY:

GERARDO MORALES

DATE:

10/9/12

SCALE:

AS SHOWN

SIZE:

11x17


TITLE:

**IDF-L
WIRELESS
ACCESS POINT
PLAN**

SHEET #:

T14

14 OF 29

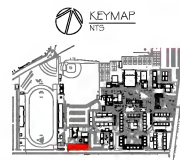

PREPARED FOR:
**EL MONTE
UNION HIGH
SCHOOL
DISTRICT**

SITE:
**ARROYO
HIGH SCHOOL**

4921 CEDAR AVENUE
EL MONTE, CA 91732



**AS-BUILT
PROJECT NO. 5231**



IDF-M - WIRELESS ACCESS POINT PLAN
SCALE: 3/32" = 1'-0"

LEGEND

⊗ WIRELESS ACCESS POINT

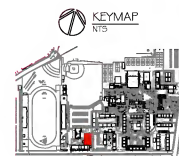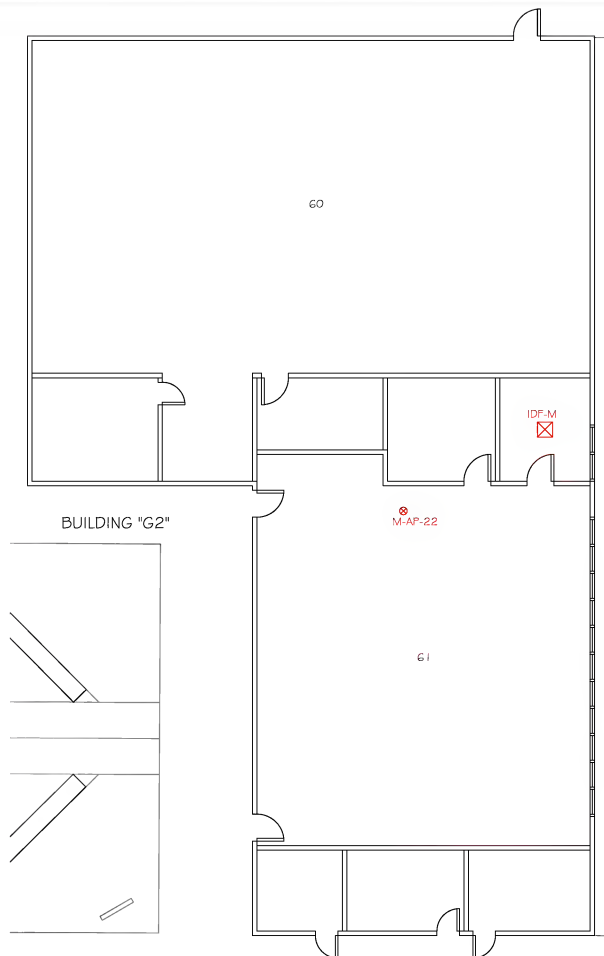

REVISIONS:

Δ DATE: DESCRIPTION:

DRAWN BY:

GERARDO MORALES

DATE:

10/9/12

SCALE:

AS SHOWN

SIZE:

11 x 17

TITLE:

**IDF-M
WIRELESS
ACCESS POINT
PLAN**

* PROPERTY OF EASY NETWORKS *
* NOT TO BE USED BY OTHERS WITHOUT PERMISSION *

SHEET #:

T15

15 OF 29


PREPARED FOR:
**EL MONTE
UNION HIGH
SCHOOL
DISTRICT**

SITE:
**ARROYO
HIGH SCHOOL**

4921 CEDAR AVENUE
EL MONTE, CA 91732

**AS-BUILT
PROJECT NO. 5231**


BUILDING "G"

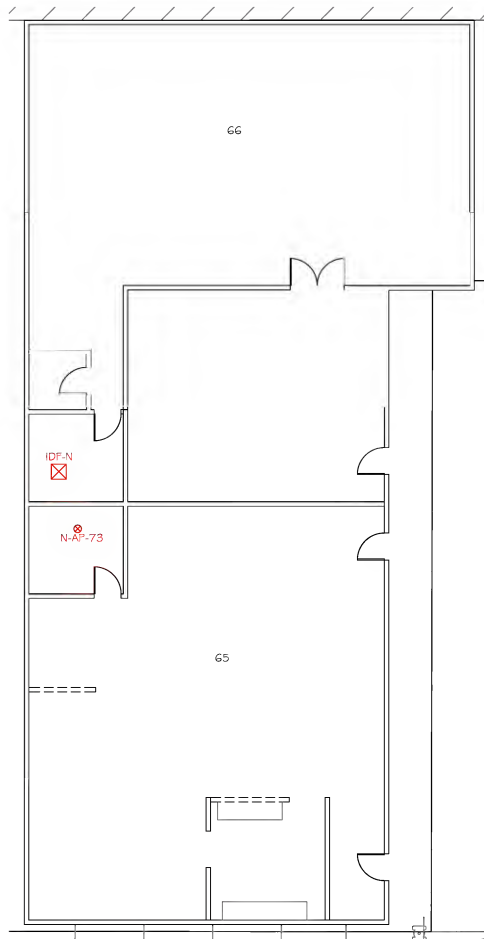

IDF-N - WIRELESS ACCESS POINT PLAN
SCALE: 3/32" = 1'-0"

LEGEND

⊗ WIRELESS ACCESS POINT

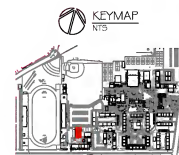

REVISIONS:

Δ DATE: DESCRIPTION:

DRAWN BY:

GERARDO MORALES

DATE:

10/9/12

SCALE:

AS SHOWN

SIZE:

11 x 17

TITLE:

**IDF-N
WIRELESS
ACCESS POINT
PLAN**

* PROPERTY OF EASY NETWORKS *
* NOT TO BE USED BY OTHERS WITHOUT PERMISSION *

SHEET #:

T16

16 OF 29

PREPARED FOR:
**EL MONTE
UNION HIGH
SCHOOL
DISTRICT**

SITE:
**ARROYO
HIGH SCHOOL**

4921 CEDAR AVENUE
EL MONTE, CA 91732

**AS-BUILT
PROJECT NO. 5231**

REVISIONS:

DATE: **DESCRIPTION:**

DRAWN BY:

GERARDO MORALES

DATE: 10/9/12

SCALE: AS SHOWN

SIZE: 11x17

TITLE:


**IDF-O
WIRELESS
ACCESS POINT
PLAN**

• PROPERTY OF EASY NETWORKS •
• FOR USE BY OUR CUSTOMERS ONLY •

SHEET #:

T17

17 OF 29

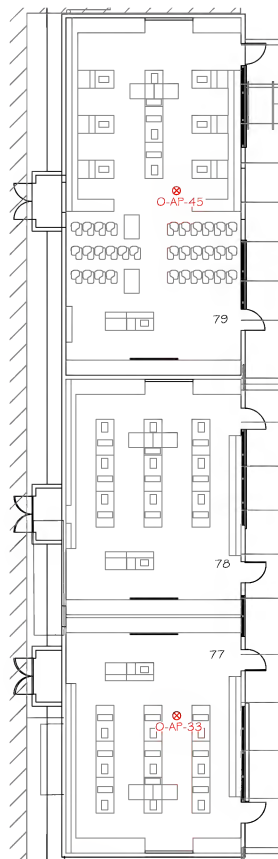

IDF-O




IDF-O - WIRELESS ACCESS POINT PLAN

SCALE: 1/16" = 1'-0"

LEGEND

WIRELESS ACCESS POINT

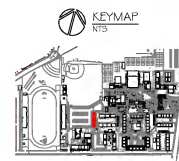

PREPARED FOR:
**EL MONTE
UNION HIGH
SCHOOL
DISTRICT**

SITE:
**ARROYO
HIGH SCHOOL**

4921 CEDAR AVENUE
EL MONTE, CA 91732

**AS-BUILT
PROJECT NO. 5231**

REVISIONS:

DATE DESCRIPTION:

DRAWN BY:

GERARDO MORALES

DATE: 10/9/12

SCALE: AS SHOWN

SIZE: 11x17

TITLE:


**IDF-Q
WIRELESS
ACCESS POINT
PLAN**

* PROPERTY OF EASY NETWORKS
* NOT TO BE USED FOR REPRODUCTION

SHEET #:

T18

18 OF 29

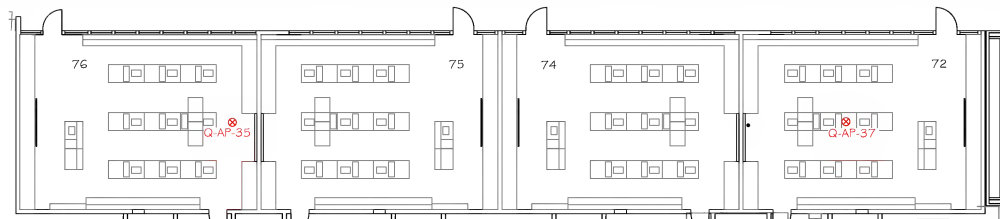


IDF-Q



IDF- Q - WIRELESS ACCESS POINT PLAN
SCALE: 1/16" = 1'-0"

LEGEND

⊗ WIRELESS ACCESS POINT

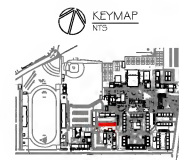

PREPARED FOR:
**EL MONTE
UNION HIGH
SCHOOL
DISTRICT**

SITE:
**ARROYO
HIGH SCHOOL**

4921 CEDAR AVENUE
EL MONTE, CA 91732

**AS-BUILT
PROJECT NO. 5231**

REVISIONS:

DATE: **DESCRIPTION:**

DRAWN BY:

GERARDO MORALES

DATE: 10/9/12

SCALE: AS SHOWN

SIZE: 11x17

TITLE:


**IDF-R
WIRELESS
ACCESS POINT
PLAN**

*** PROPERTY OF EASY NETWORKS ***
*** NOT TO BE USED FOR REPRODUCTION ***

SHEET #:

T19

19 OF 29

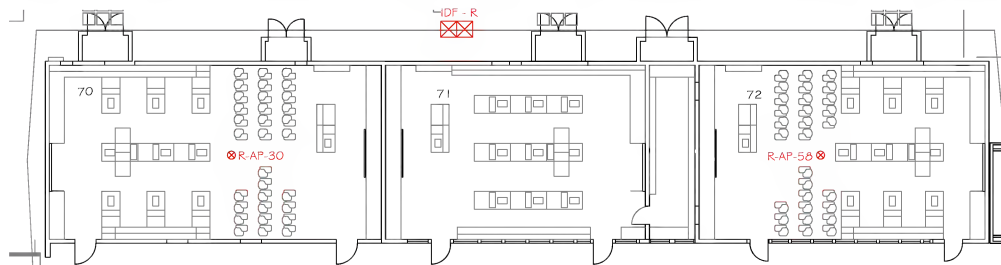

IDF- R - WIRELESS ACCESS POINT PLAN

SCALE: 1/16" = 1'-0"

LEGEND

⊗ WIRELESS ACCESS POINT



PREPARED FOR:
**EL MONTE
UNION HIGH
SCHOOL
DISTRICT**

SITE:
**ARROYO
HIGH SCHOOL**

4921 CEDAR AVENUE
EL MONTE, CA 91732

AS-BUILT
PROJECT NO. 5231

REVISIONS:

DATE DESCRIPTION

DRAWN BY:

GERARDO MORALES

DATE: 10/9/12

SCALE: AS SHOWN

SIZE: 11x17

TITLE:


**IDF-S
WIRELESS
ACCESS POINT
PLAN**

PROPERTY OF EASY NETWORKS
DO NOT USE ON OTHER PROJECTS WITHOUT PERMISSION

SHEET #:

T20

20 OF 29

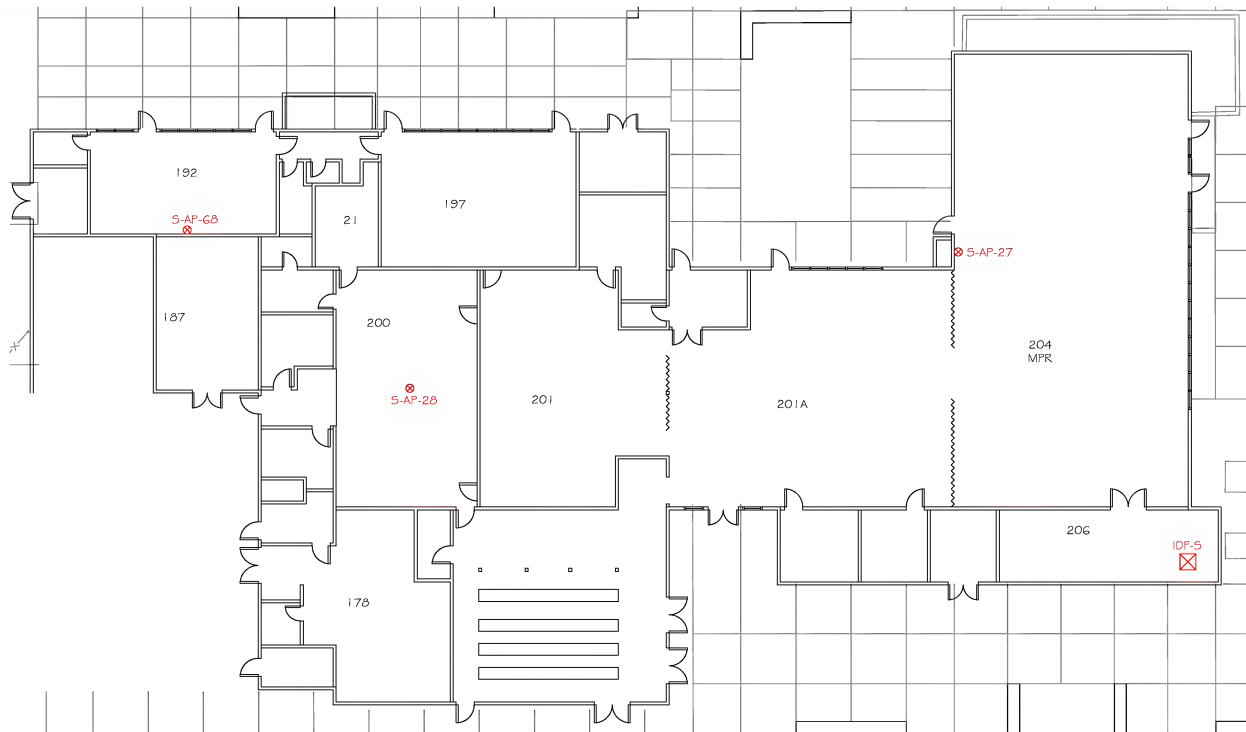



IDF-S - WIRELESS ACCESS POINT PLAN

SCALE: 1/16" = 1'-0"

LEGEND

WIRELESS ACCESS POINT

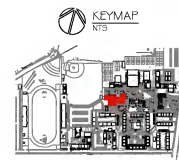

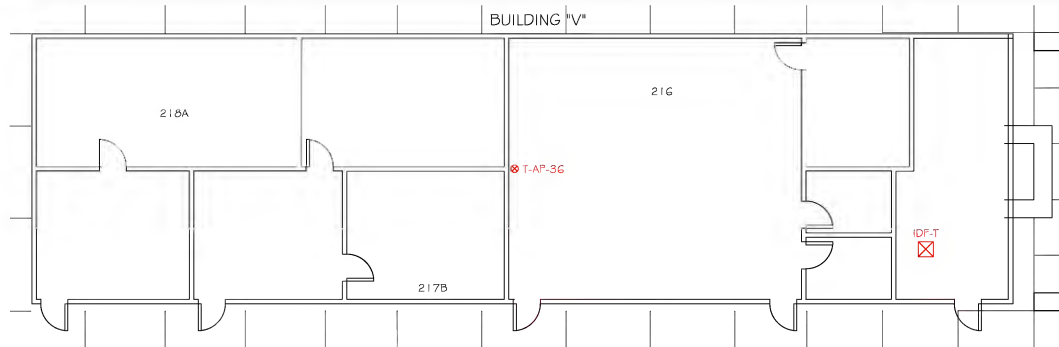

IDF- T - WIRELESS ACCESS POINT PLAN
SCALE: 3/32" = 1'-0"

LEGEND

⊗ WIRELESS ACCESS POINT

EASYNETWORKS
CABLING

3534 SHELLY WAY
RIVERSIDE, CA 92503
OFFICE: (951) 512-9119
FAX: (951) 512-9125
ST. LC: 1-800-770

PREPARED FOR:
**EL MONTE
UNION HIGH
SCHOOL
DISTRICT**

SITE:
**ARROYO
HIGH SCHOOL**

4921 CEDAR AVENUE
EL MONTE, CA 91732

**AS-BUILT
PROJECT NO. 5231**

REVISIONS:

Δ DATE: DESCRIPTION:

DRAWN BY:

GERARDO MORALES

DATE:

10/9/12

SCALE:

AS SHOWN

SIZE:

11x17

TITLE:

**IDF-T
WIRELESS
ACCESS POINT
PLAN**

* PROPERTY OF E.O. DE NECKHOFF &
ASSOCIATES INC. 100-70000-000-000

SHEET #:

T21

21 OF 29



PREPARED FOR:
**EL MONTE
UNION HIGH
SCHOOL
DISTRICT**

SITE:
**ARROYO
HIGH SCHOOL**

4921 CEDAR AVENUE
EL MONTE, CA 91732

**AS-BUILT
PROJECT NO. 5231**

REVISIONS:

 DATE: DESCRIPTION:

DRAWN BY:

GERARDO MORALES

DATE: 10/9/12

SCALE: AS SHOWN

SIZE: 11x17

TITLE:

**IDF-U
WIRELESS
ACCESS POINT
PLAN**


* PROPERTY OF EASY NETWORKS *
* NOT TO BE USED FOR REPRODUCTION *

SHEET #:

T22

22 OF 29

BUILDING "J"

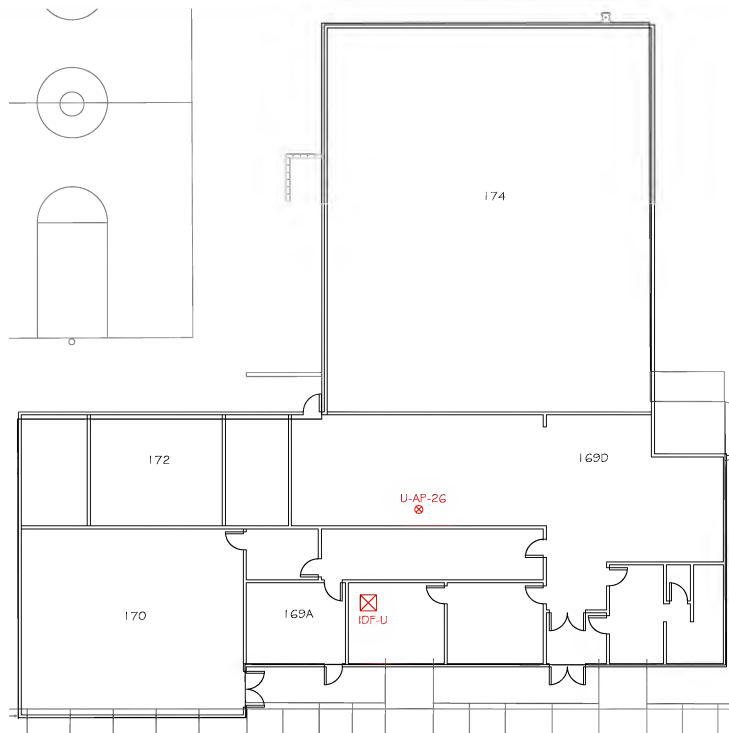


IDF- U - WIRELESS ACCESS POINT PLAN

SCALE: 1/16" = 1'-0"

LEGEND

 WIRELESS ACCESS POINT

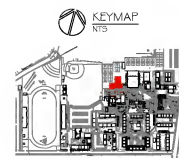

PREPARED FOR:
**EL MONTE
UNION HIGH
SCHOOL
DISTRICT**

SITE:
**ARROYO
HIGH SCHOOL**

4921 CEDAR AVENUE
EL MONTE, CA 91732

**AS-BUILT
PROJECT NO. 5231**

REVISIONS:

DATE DESCRIPTION:

DRAWN BY:

GERARDO MORALES

DATE: 10/9/12

SCALE: AS SHOWN

SIZE: 11x17

TITLE:


**IDF-V
WIRELESS
ACCESS POINT
PLAN**

* PROPERTY OF EASY NETWORKS *
* NOT TO BE USED FOR REPRODUCTION *

SHEET #:

T23

23 OF 29

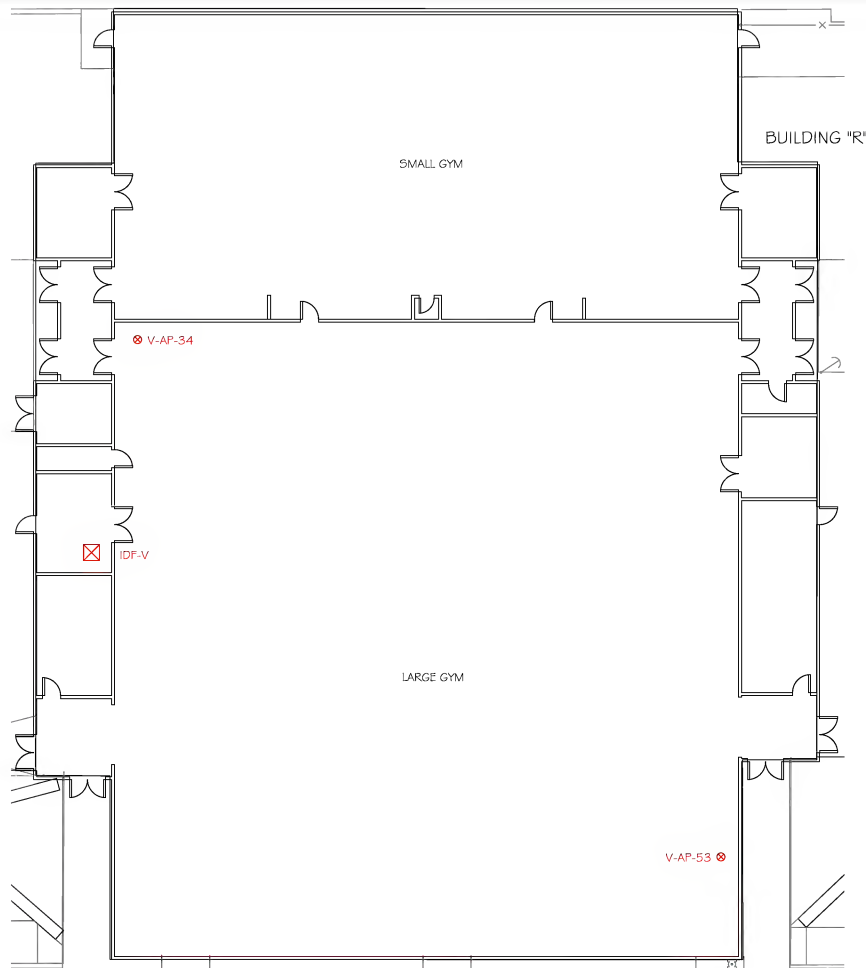


IDF- V - WIRELESS ACCESS POINT PLAN

SCALE: 1/16" = 1'-0"

LEGEND

● WIRELESS ACCESS POINT

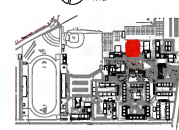

PREPARED FOR:
**EL MONTE
UNION HIGH
SCHOOL
DISTRICT**

SITE:
**ARROYO
HIGH SCHOOL**

4021 CEDAR AVENUE
EL MONTE, CA 91732

**AS-BUILT
PROJECT NO. 5231**

REVISIONS:

DATE DESCRIPTION:

DRAWN BY:

GERARDO MORALES

DATE: 10/9/12

SCALE: AS SHOWN

SIZE: 11x17

TITLE:


**IDF-W
WIRELESS
ACCESS POINT
PLAN**

*** PROPERTY OF EASY NETWORKS ***
*** NOT TO BE USED BY OTHER NETWORKING FIRMS ***

SHEET #:

T24

24 OF 29

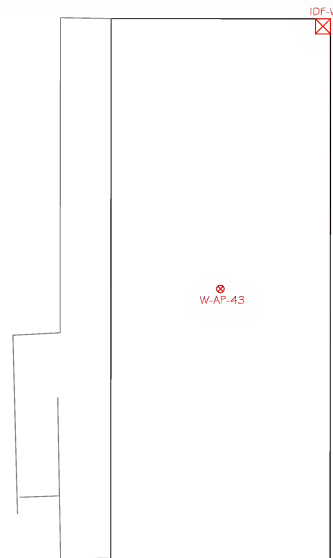


IDF-W - WIRELESS ACCESS POINT PLAN

SCALE: 3/32" = 1'-0"

LEGEND

WIRELESS ACCESS POINT

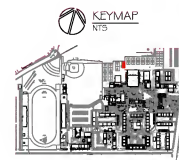

PREPARED FOR:
**EL MONTE
UNION HIGH
SCHOOL
DISTRICT**

SITE:
**ARROYO
HIGH SCHOOL**

4921 CEDAR AVENUE
EL MONTE, CA 91732

**AS-BUILT
PROJECT NO. 5231**

BUILDING "H"

GIRLS
LOCKER
ROOM



IDF- X - WIRELESS ACCESS POINT PLAN


SCALE: 1/16" = 1'-0"

LEGEND

⊗ WIRELESS ACCESS POINT

IDF-X ⊗

X-AP-25 ⊗

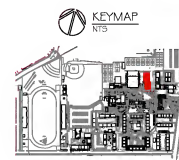

REVISIONS:

Δ DATE DESCRIPTION

DRAWN BY:

GERARDO MORALES

DATE:

10/9/12

SCALE:

AS SHOWN

SIZE:

11x17

TITLE:

**IDF-X
WIRELESS
ACCESS POINT
PLAN**

* PROPERTY OF EASY NETWORKS *
* NOT TO BE USED BY OTHERS WITHOUT PERMISSION *

SHEET #:

T25


25 OF 29

PREPARED FOR:
**EL MONTE
UNION HIGH
SCHOOL
DISTRICT**

SITE:
**ARROYO
HIGH SCHOOL**

4921 CEDAR AVENUE
EL MONTE, CA 91732

**AS-BUILT
PROJECT NO. 5231**

 **IDF- Y - WIRELESS ACCESS POINT PLAN**
SCALE: 3/16" = 1'-0"

LEGEND

 **WIRELESS ACCESS
POINT**

REVISIONS:

 **DATE: DESCRIPTION:**

DRAWN BY:

GERARDO MORALES

DATE: 10/9/12

SCALE: AS SHOWN

SIZE: 11x17

TITLE:


**IDF-Y
WIRELESS
ACCESS POINT
PLAN**

• PROPERTY OF ESN NETWORKS
• NOT TO BE USED FOR REPRODUCTION

SHEET #:

T26

26 OF 29

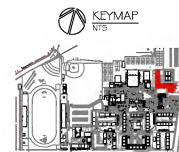

BUILDING "M"

91

Y-AP-32

Y-AP-30

IDF-Y

BUILDING "I"

92

Y-AP-63

GIRLS
LOCKER
ROOM

Y-AP-41

94

PREPARED FOR:
**EL MONTE
UNION HIGH
SCHOOL
DISTRICT**

SITE:
**ARROYO
HIGH SCHOOL**

4921 CEDAR AVENUE
EL MONTE, CA 91732

AS-BUILT
PROJECT NO. 5231

REVISIONS:

DATE: DESCRIPTION:

DRAWN BY:

GERARDO MORALES

DATE: 10/9/12

SCALE: AS SHOWN

SIZE: 11x17

TITLE:


**IDF-AA
WIRELESS
ACCESS POINT
PLAN**

* PROPERTY OF EASY NETWORKS
* NOT TO BE USED BY CUSTOMERS ONLY

SHEET #:

T27

27 OF 29

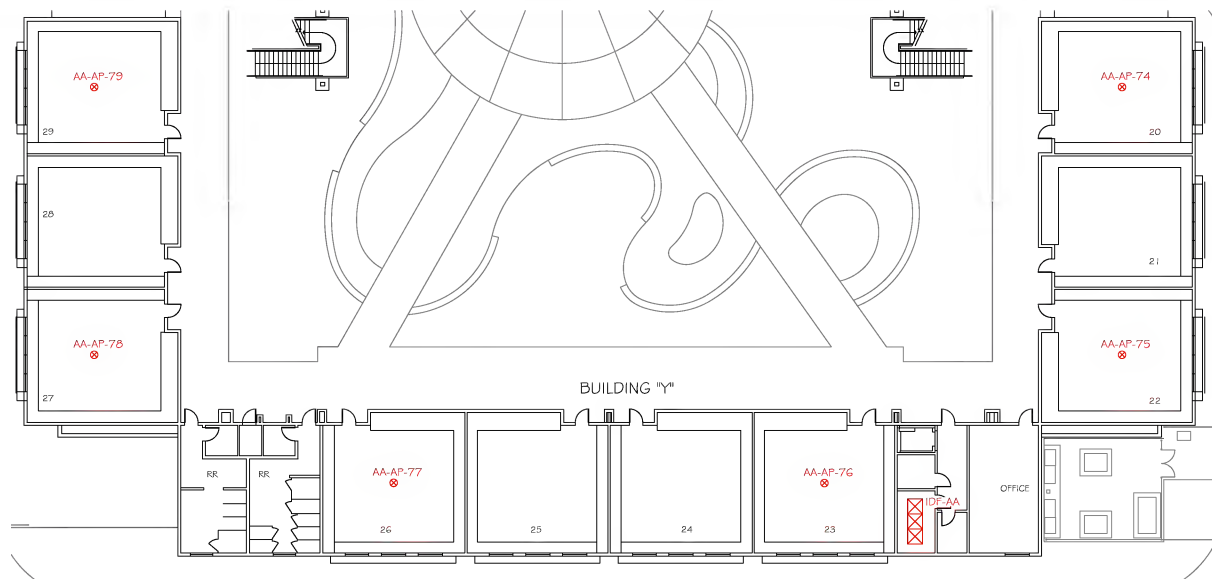


IDF- AA - WIRELESS ACCESS POINT PLAN

SCALE: 3/64" = 1'-0"

LEGEND

⊙ WIRELESS ACCESS
POINT

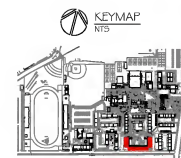

PREPARED FOR:
**EL MONTE
UNION HIGH
SCHOOL
DISTRICT**

SITE:
**ARROYO
HIGH SCHOOL**

4921 CEDAR AVENUE
EL MONTE, CA 91732

**AS-BUILT
PROJECT NO. 5231**

REVISIONS:

DATE DESCRIPTION:

DRAWN BY:

GERARDO MORALES

DATE: 10/9/12

SCALE: AS SHOWN

SIZE: 11x17

TITLE:


**IDF-BB
WIRELESS
ACCESS POINT
PLAN**

* PROPERTY OF EASY NETWORKS
* NOT TO BE USED BY CUSTOMER FOR ANY OTHER PROJECT

SHEET #:

T28

28 OF 29

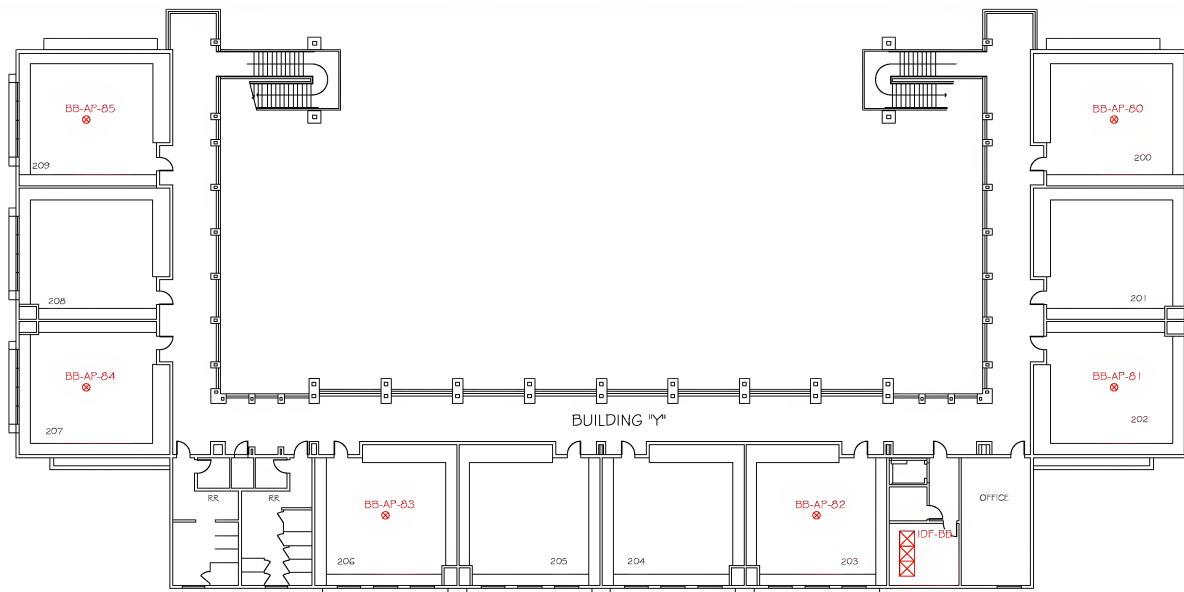


IDF- BB - WIRELESS ACCESS POINT PLAN

SCALE: 3/64" = 1'-0"

LEGEND

 **WIRELESS ACCESS
POINT**

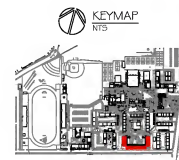

PREPARED FOR:
**EL MONTE
UNION HIGH
SCHOOL
DISTRICT**

SITE:
**ARROYO
HIGH SCHOOL**

4921 CEDAR AVENUE
EL MONTE, CA 91732


**AS-BUILT
PROJECT NO. 5231**



IDF- CC - WIRELESS ACCESS POINT PLAN
SCALE: 3/32" = 1'-0"

LEGEND

⊙ WIRELESS ACCESS POINT

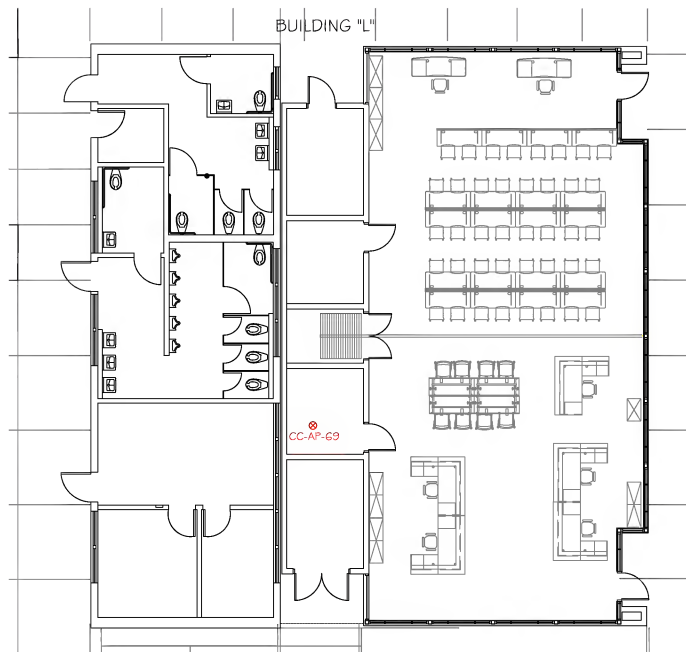

⊗
IDF-CC



REVISIONS:

Δ DATE DESCRIPTION

DRAWN BY:

GERARDO MORALES

DATE: 10/9/12

SCALE: AS SHOWN

SIZE: 11x17


TITLE:

**IDF-CC
WIRELESS
ACCESS POINT
PLAN**

SHEET #:

T29


29 OF 29

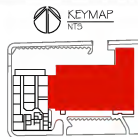

FIRST FLOOR - WIRELESS ACCESS POINT PLAN N.T.S.

LEGEND

⊗ WIRELESS ACCESS POINT

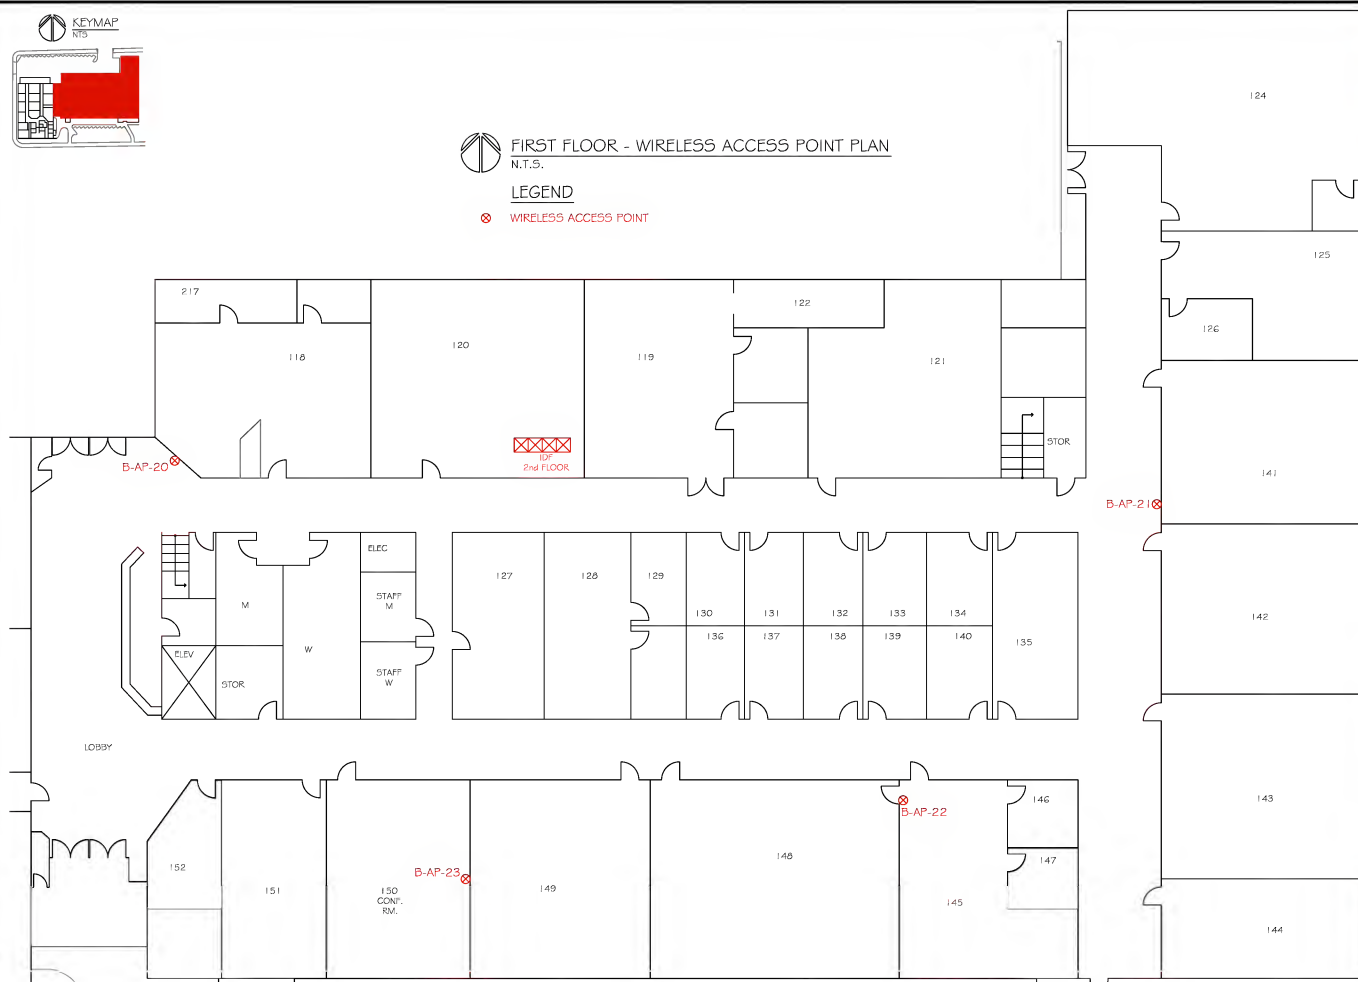

EASYNETWORKS
CABLING

3038 SHELLEY WAY
RIVERSIDE, CA 92503
OFFICE: 951-502-8119
FAX: 951-502-8120
ST. LC: 1-800-770

PREPARED FOR:
**EL MONTE
UNION HIGH
SCHOOL
DISTRICT**

SITE:
**EL MONTE
ADULT SCHOOL**

10807 RAMONA BLVD
EL MONTE, CA 91731

**AS-BUILT
PROJECT NO. 5231**

REVISIONS:

Δ DATE DESCRIPTION:

DRAWN BY:

GERARDO MORALES

DATE:

10/25/12

SCALE:

AS SHOWN

SIZE:

11x17

TITLE:


**FIRST FLOOR
WIRELESS
ACCESS POINT
PLAN**

*PROPERTY OF EAST TECHNOLOGY
*NOT TO BE USED BY EAST TECHNOLOGY ONLY

SHEET#:

T1

1 OF 2

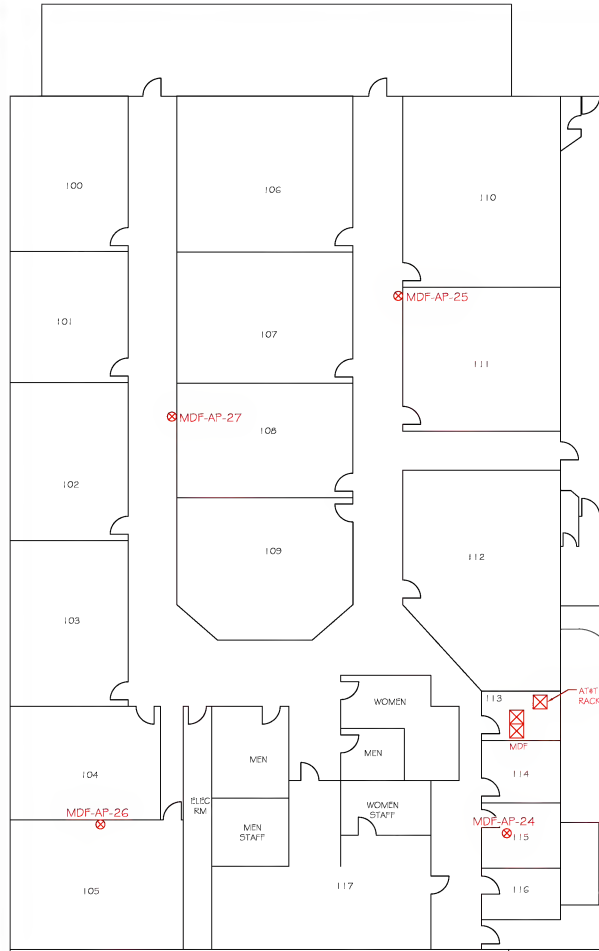

WIRELESS ACCESS POINT SCHEDULE			
AP #	Mac Address	Asset Tag	LOCATION
EMA-S-AP_20	002438F2C87C	41060	Reception
EMA-S-AP_21	002438F2C9A4	41059	Outside of RM 141
EMA-S-AP_22	002438F2C85C	41062	Room 145
EMA-S-AP_23	002438F2CA00	41061	Conference Office
EMA-MDF-AP_24	002438F2C960	41064	Room 115
EMA-MDF-AP_25	002438F2C8F4	41065	Outside of RM 111
EMA-MDF-AP_26	002438F2C870	41066	Room 105
EMA-MDF-AP_27	002438F2C8FC	41063	Outside RM 102



ESL BUILDING - WIRELESS ACCESS POINT PLAN
N.T.S.

LEGEND

⊗ WIRELESS ACCESS POINT

EASYNETWORKS
CABLING

3038 SHELLY WAY
RIVERSIDE, CA 92503
OFFICE: 951-702-8119
FAX: 951-702-8105
ST. LOC: 1-800-570

PREPARED FOR:
**EL MONTE
UNION HIGH
SCHOOL
DISTRICT**

SITE:
**EL MONTE
ADULT SCHOOL**

10807 RAMONA BLVD
EL MONTE, CA 91731

AS-BUILT
PROJECT NO. 5231

REVISIONS:

Δ DATE DESCRIPTION:

DRAWN BY:
BERARDO MORALES

DATE: 10/25/12
SCALE: AS SHOWN
SIZE: 11x17

TITLE:
**ESL BLDG.
WIRELESS
ACCESS POINT
PLAN**


* PROPERTY OF EASY NETWORKS
* NOT TO BE USED BY OTHERS WITHOUT EASY NETWORKS PERMISSION

SHEET #:

T2

2 OF 2

KEYMAP
N.T.S.

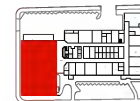

PREPARED FOR:
**EL MONTE
UNION HIGH
SCHOOL
DISTRICT**

SITE:
**EL MONTE
HIGH SCHOOL**

3048 TYLER AVE.
EL MONTE, CA 91731

AS-BUILT
PROJECT NO. 5231

REVISIONS:

DATE DESCRIPTION:

DRAWN BY:

GERARDO MORALES

DATE: 10/9/12

SCALE: AS SHOWN

SIZE: 11 X 17

TITLE:

**WIRELESS
ACCESS POINT
PLAN**


SHEET#:

T1

1 OF 17

EASY NETWORKS - 5231 - 10/17/2012 4:44 PM T1 Tab1.doc

AP #	Mac Address	Apnt Tg	LOCATION
WPA-AP-20	002460000000	0070	Room202 Auditorium
WPA-AP-21	002460000000	0070	Room202 Auditorium
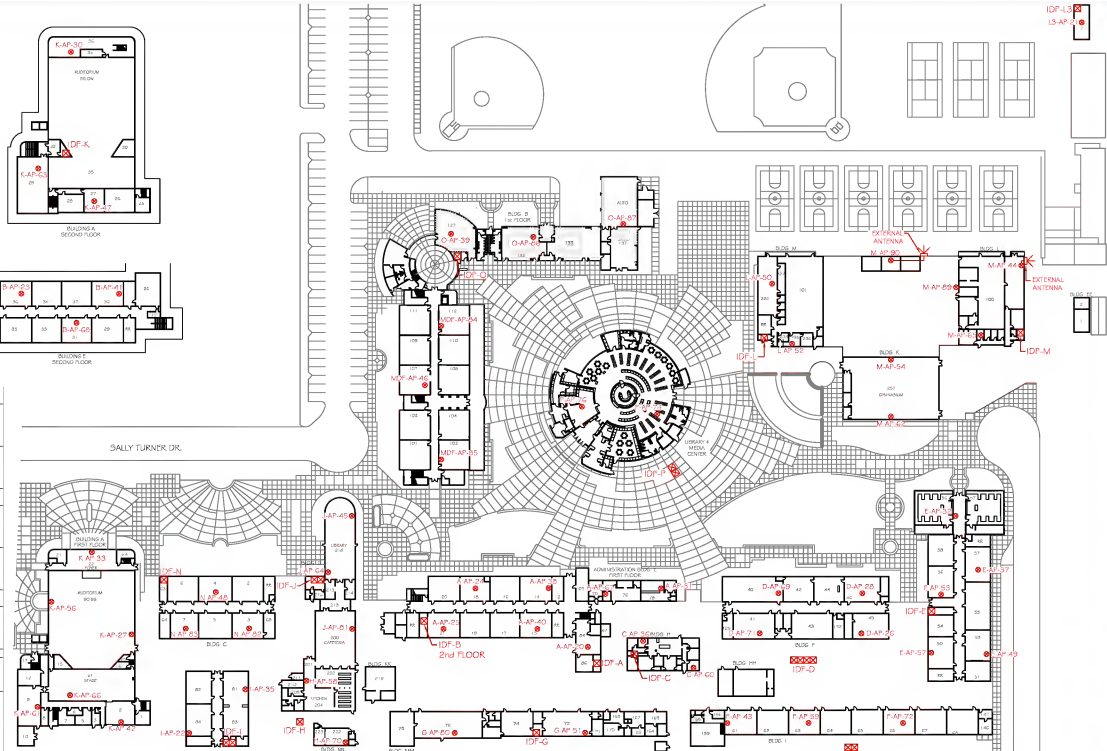

WIRELESS ACCESS POINT PLAN
SCALE: 1" = 100'-0"
LEGEND
● WIRELESS ACCESS POINT

PREPARED FOR:
**EL MONTE
UNION HIGH
SCHOOL
DISTRICT**

SITE:
**EL MONTE
HIGH SCHOOL**

3048 TYLER AVE.
EL MONTE, CA 91731

**AS-BUILT
PROJECT NO. 5231**

REVISIONS:

DATE: DESCRIPTION:

DRAWN BY:

GERARDO MORALES

DATE:

10/9/12

SCALE:

AS SHOWN

SIZE:

11x17

TITLE:


**MDF
WIRELESS
ACCESS POINT
PLAN**

*PROPERTY LINE & EASEMENT INDICATED
*NOT TO BE USED FOR CONSTRUCTION ONLY

SHEET #:

T2

2 OF 17

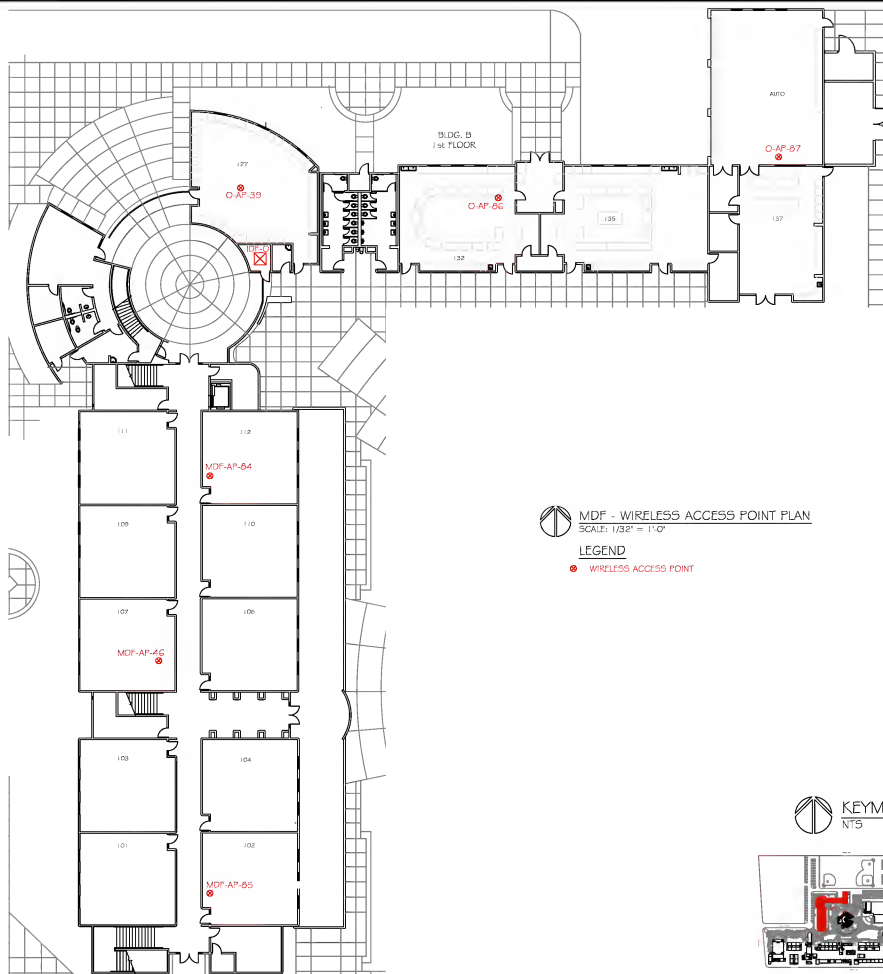

MDF - WIRELESS ACCESS POINT PLAN

SCALE: 1/32" = 1'-0"

LEGEND

● WIRELESS ACCESS POINT



PREPARED FOR:
**EL MONTE
UNION HIGH
SCHOOL
DISTRICT**

SITE:
**EL MONTE
HIGH SCHOOL**

3048 TYLER AVE
EL MONTE, CA 91731

**AS-BUILT
PROJECT NO. 5231**

REVISIONS:

DATE: **DESCRIPTION:**

DRAWN BY:

GERARDO MORALES

DATE:

10/9/12

SCALE:

AS SHOWN

SIZE:

11x17

TITLE:

**IDF-A
WIRELESS
ACCESS POINT
PLAN**


* PROPERTY OF EASY NETWORKS *
* NOT TO BE USED FOR REPRODUCTION *

SHEET #:

T3

3 OF 17

ADMINISTRATION BLDG. E
FIRST FLOOR

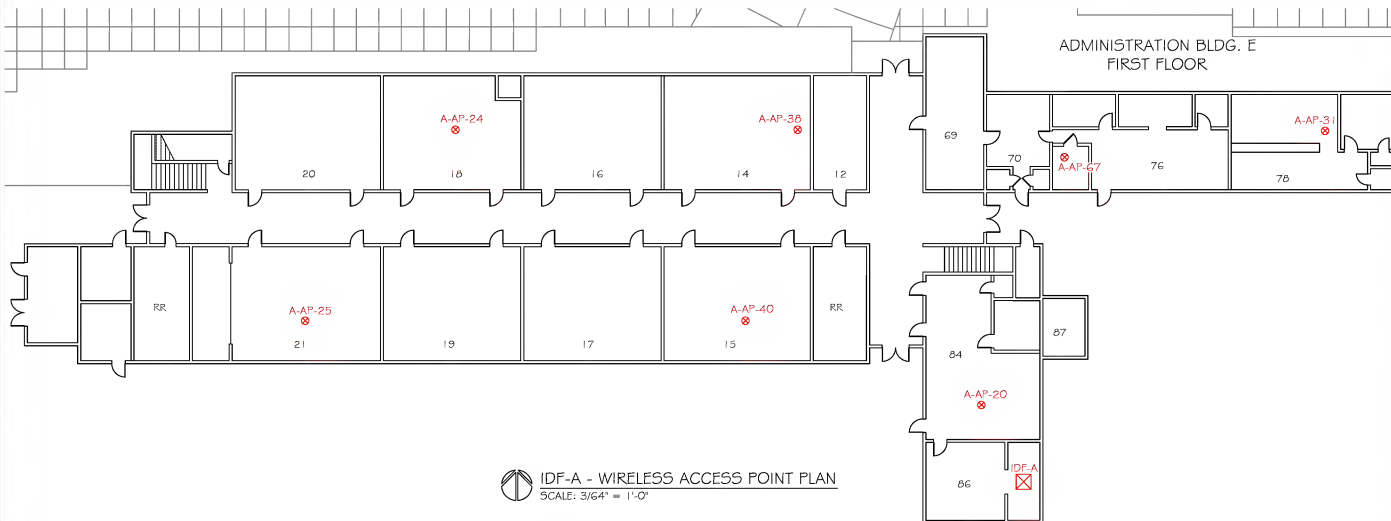

IDF-A - WIRELESS ACCESS POINT PLAN
SCALE: 3/64" = 1'-0"

LEGEND

 WIRELESS ACCESS POINT



PREPARED FOR:
**EL MONTE
UNION HIGH
SCHOOL
DISTRICT**

SITE:
**EL MONTE
HIGH SCHOOL**

3048 TYLER AVE
EL MONTE, CA 91731

**AS-BUILT
PROJECT NO. 5231**

REVISIONS:

DATE: **DESCRIPTION:**

DRAWN BY:

GERARDO MORALES

DATE:

10/9/12

SCALE:

AS SHOWN

SIZE:

11x17

TITLE:


**IDF-B
WIRELESS
ACCESS POINT
PLAN**

PROPERTY OF EASY NETWORKS
NOT TO BE USED FOR REPRODUCTION

SHEET#:

T4

4 OF 17

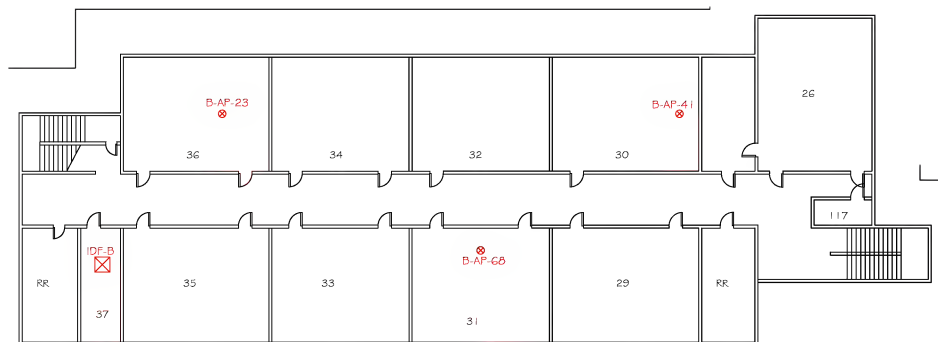

IDF-B - WIRELESS ACCESS POINT PLAN
SCALE: 3/64" = 1'-0"

LEGEND

⊗ WIRELESS ACCESS POINT




PREPARED FOR:
**EL MONTE
UNION HIGH
SCHOOL
DISTRICT**

SITE:
**EL MONTE
HIGH SCHOOL**

3048 TYLER AVE
EL MONTE, CA 91731

**AS-BUILT
PROJECT NO. 5231**

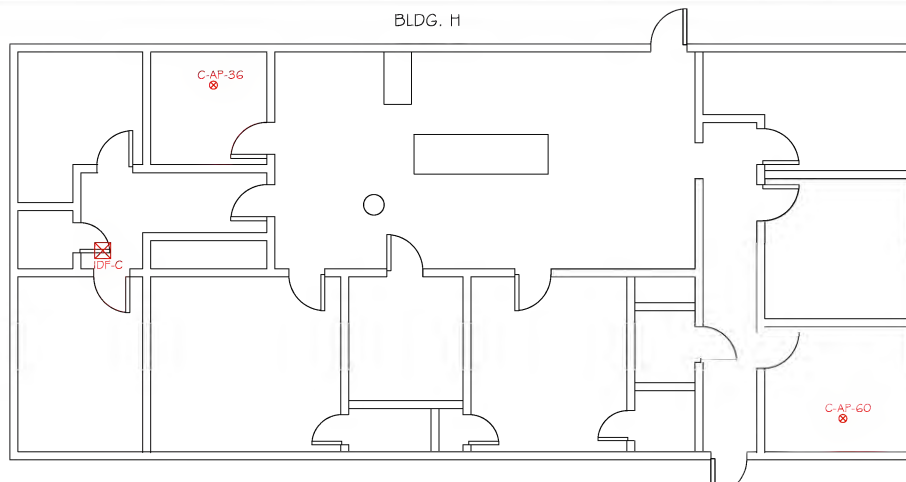

IDF-C - WIRELESS ACCESS POINT PLAN
SCALE: 1/8" = 1'-0"

LEGEND

⊗ WIRELESS ACCESS POINT

REVISIONS:

Δ DATE: DESCRIPTION:

DRAWN BY:

GERARDO MORALES

DATE:

10/9/12

SCALE:

AS SHOWN

SIZE:

11x17

TITLE:

**IDF-C
WIRELESS
ACCESS POINT
PLAN**

* PROPERTY OF EASY NETWORKS *
* NOT TO BE USED BY OTHERS WITHOUT PERMISSION *

SHEET #:

T5

5 OF 17



PREPARED FOR:
**EL MONTE
UNION HIGH
SCHOOL
DISTRICT**

SITE:
**EL MONTE
HIGH SCHOOL**

3048 TYLER AVE
EL MONTE, CA 91731

**AS-BUILT
PROJECT NO. 5231**

REVISIONS:

DATE: DESCRIPTION:

DRAWN BY:

GERARDO MORALES

DATE:

10/9/12

SCALE:

AS SHOWN

SIZE:

11x17

TITLE:

**IDF-D
WIRELESS
ACCESS POINT
PLAN**


* PROPERTY OF EASY NETWORKS *
* NOT TO BE USED FOR REPRODUCTION ONLY *

SHEET #:

T6

6 OF 17

BLDG. F

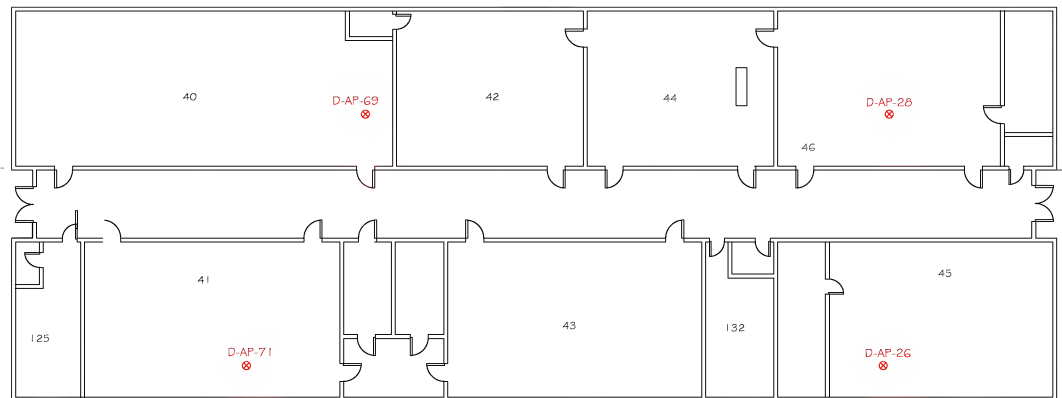

IDF-D



IDF-D - WIRELESS ACCESS POINT PLAN

SCALE: 1/16" = 1'-0"

LEGEND

⊗ WIRELESS
ACCESS
POINT



PREPARED FOR:
**EL MONTE
UNION HIGH
SCHOOL
DISTRICT**

SITE:
**EL MONTE
HIGH SCHOOL**

3048 TYLER AVE
EL MONTE, CA 91731

**AS-BUILT
PROJECT NO. 5231**

REVISIONS:

DATE: **DESCRIPTION:**

DRAWN BY:

GERARDO MORALES

DATE:

10/9/12

SCALE:

AS SHOWN

SIZE:

11x17

TITLE:


**IDF-E
WIRELESS
ACCESS POINT
PLAN**

*** PROPERTY OF EASY NETWORKS ***
*** NOT TO BE USED BY CUSTOMER FOR OTHER PROJECTS ***

SHEET #:

T7

7 OF 17

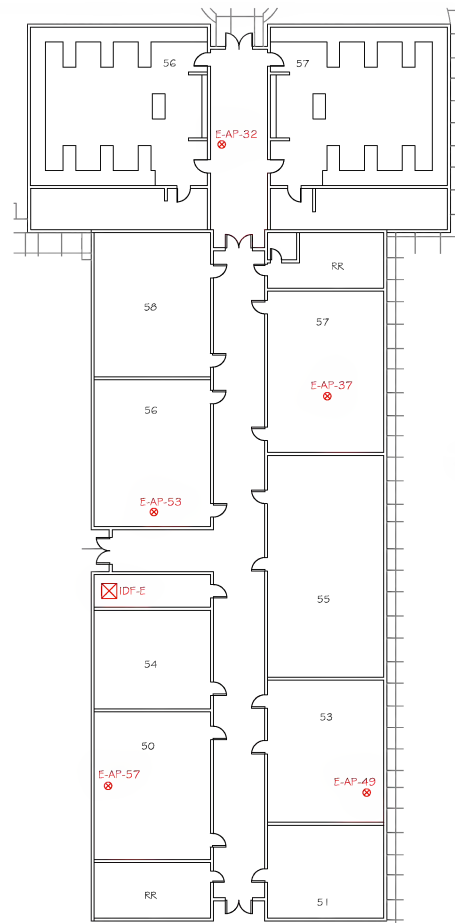

IDF-E - WIRELESS ACCESS POINT PLAN
SCALE: 3/64" = 1'-0"

LEGEND

WIRELESS ACCESS POINT



PREPARED FOR:
**EL MONTE
UNION HIGH
SCHOOL
DISTRICT**

SITE:
**EL MONTE
HIGH SCHOOL**

3048 TYLER AVE
EL MONTE, CA 91731

**AS-BUILT
PROJECT NO. 5231**

REVISIONS:

DATE: **DESCRIPTION:**

DRAWN BY:

GERARDO MORALES

DATE:

10/9/12

SCALE:

AS SHOWN

SIZE:

11x17

TITLE:

**IDF-F
WIRELESS
ACCESS POINT
PLAN**

PROPERTY OF EASY NETWORKS
NOT TO BE USED BY CUSTOMER FOR OTHER PROJECTS

SHEET #:

T8

8 OF 17

BLDG. I

F-AP-43

F-AP-59

F-AP-72

IDF-F




IDF-F - WIRELESS ACCESS POINT PLAN

SCALE: 3/16" = 1'-0"

LEGEND

⊗ WIRELESS ACCESS POINT



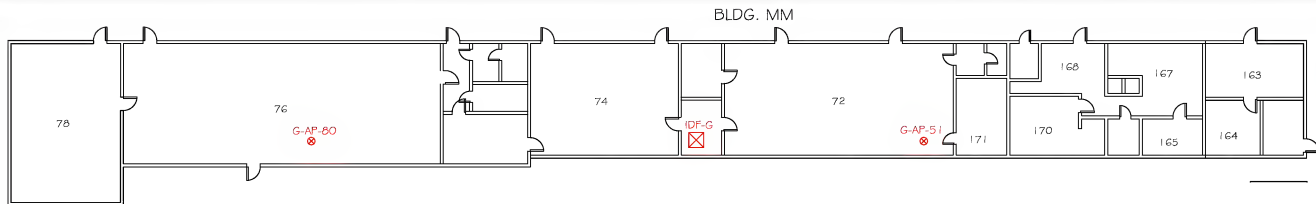

IDF-G - WIRELESS ACCESS POINT PLAN

SCALE: 3/16" = 1'-0"

LEGEND

❌ WIRELESS ACCESS POINT



EASYNETWORKS
CABLING

3038 SHELLEY WAY
RIVERSIDE, CA 92503
OFFICE: 951-502-8119
FAX: 951-502-8105
ST. LC: 1-502-8170

PREPARED FOR:
**EL MONTE
UNION HIGH
SCHOOL
DISTRICT**

SITE:
**EL MONTE
HIGH SCHOOL**

3048 TYLER AVE
EL MONTE, CA 91731

**AS-BUILT
PROJECT NO. 5231**

REVISIONS:

Δ	DATE	DESCRIPTION

DRAWN BY:

GERARDO MORALES

DATE:

10/9/12

SCALE:

AS SHOWN

SIZE:

11x17

TITLE:

**IDF-G
WIRELESS
ACCESS POINT
PLAN**

* PROPERTY OF EASY NETWORKS *
* NOT TO BE USED FOR REPRODUCTION *

SHEET #:

T9

9 OF 17

PREPARED FOR:
**EL MONTE
UNION HIGH
SCHOOL
DISTRICT**

SITE:
**EL MONTE
HIGH SCHOOL**


3048 TYLER AVE
EL MONTE, CA 91731

**AS-BUILT
PROJECT NO. 5231**


IDF-H - WIRELESS ACCESS POINT PLAN
SCALE: 1/16" = 1'-0"

LEGEND

⊗ WIRELESS ACCESS POINT

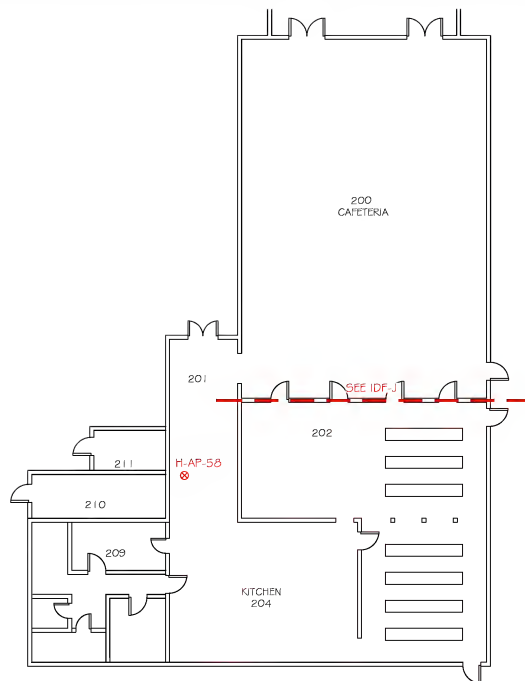

IDF-H
⊗

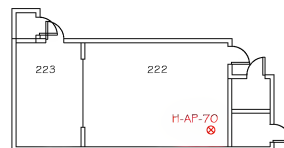

BLDG. NN



REVISIONS:

Δ DATE DESCRIPTION

DRAWN BY:

GERARDO MORALES

DATE:

10/9/12

SCALE:

AS SHOWN

SIZE:

11x17

TITLE:

**IDF-H
WIRELESS
ACCESS POINT
PLAN**

* PROPERTY OF EASY NETWORKS *
* NOT TO BE USED BY OTHERS WITHOUT PERMISSION *

SHEET #:

T10

10 OF 17

PREPARED FOR:
**EL MONTE
UNION HIGH
SCHOOL
DISTRICT**

SITE:
**EL MONTE
HIGH SCHOOL**

3048 TYLER AVE
EL MONTE, CA 91731

**AS-BUILT
PROJECT NO. 5231**

REVISIONS:

DATE: **DESCRIPTION:**

DRAWN BY:

GERARDO MORALES

DATE:

10/9/12

SCALE:

AS SHOWN

SIZE:

11x17

TITLE:


**IDF-1
WIRELESS
ACCESS POINT
PLAN**

* PROPERTY OF EASY NETWORKS *
* NOT TO BE USED BY ANY OTHER PARTY *
SHEET #:

T 11

11 OF 17

BLDG. B

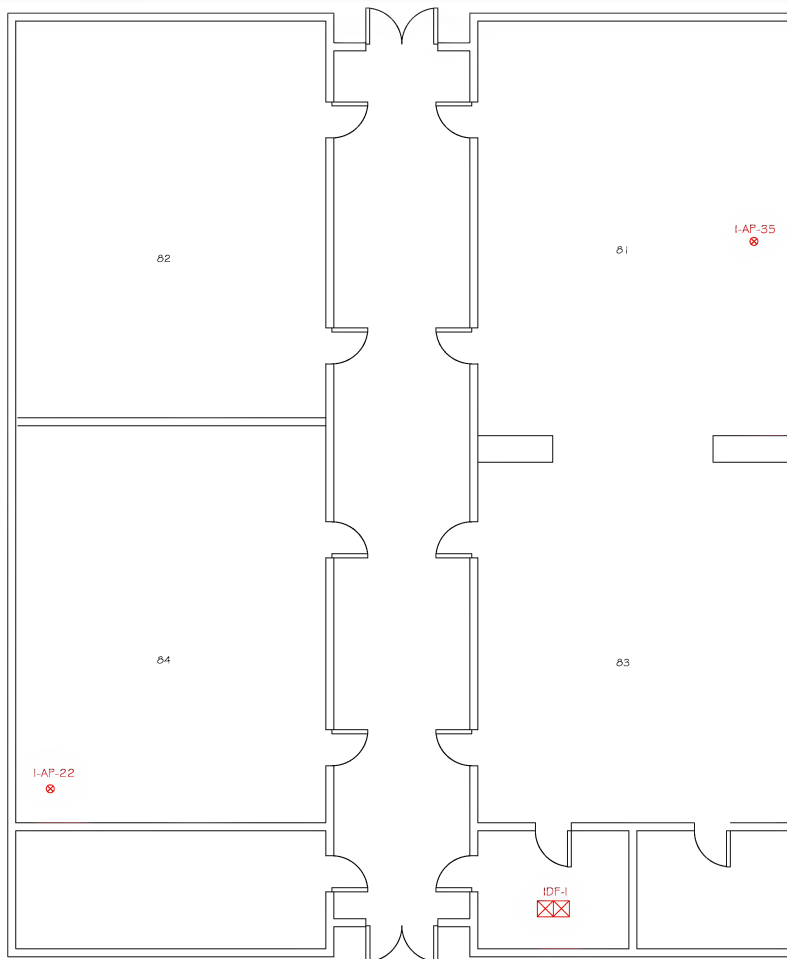

IDF-1 - WIRELESS ACCESS POINT PLAN
SCALE: 1/8" = 1'-0"

LEGEND

WIRELESS ACCESS POINT



PREPARED FOR:
**EL MONTE
UNION HIGH
SCHOOL
DISTRICT**

SITE:
**EL MONTE
HIGH SCHOOL**

3049 TYLER AVE
EL MONTE, CA 91731


**AS-BUILT
PROJECT NO. 5231**



IDF-J - WIRELESS ACCESS POINT PLAN
SCALE: 1/16" = 1'-0"

LEGEND

⊗ WIRELESS ACCESS POINT

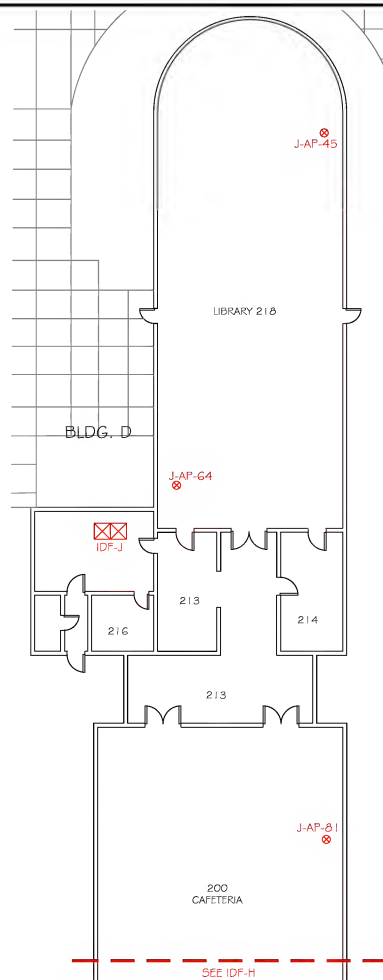

REVISIONS:

Δ DATE DESCRIPTION

DRAWN BY:

GERARDO MORALES

DATE:

10/9/12

SCALE:

AS SHOWN

SIZE:

11x17

TITLE:

**IDF-J
WIRELESS
ACCESS POINT
PLAN**

* PROPERTY OF EASY NETWORKS *
* NOT TO BE USED BY ANY OTHER PARTY *

SHEET #:

T12

12 OF 17

PREPARED FOR:
**EL MONTE
UNION HIGH
SCHOOL
DISTRICT**

SITE:
**EL MONTE
HIGH SCHOOL**

3048 TYLER AVE
EL MONTE, CA 91731

**AS-BUILT
PROJECT NO. 5231**

REVISIONS:

DATE: **DESCRIPTION:**

DRAWN BY:

GERARDO MORALES

DATE: 10/9/12

SCALE: AS SHOWN

SIZE: 11x17

TITLE:

**IDF-K
WIRELESS
ACCESS POINT
PLAN**


*PROPERTY IS EASY NETWORKS
*DO NOT USE FOR OTHER PROJECTS ONLY

SHEET #:


T13

13 OF 17

**BUILDING A
SECOND FLOOR**

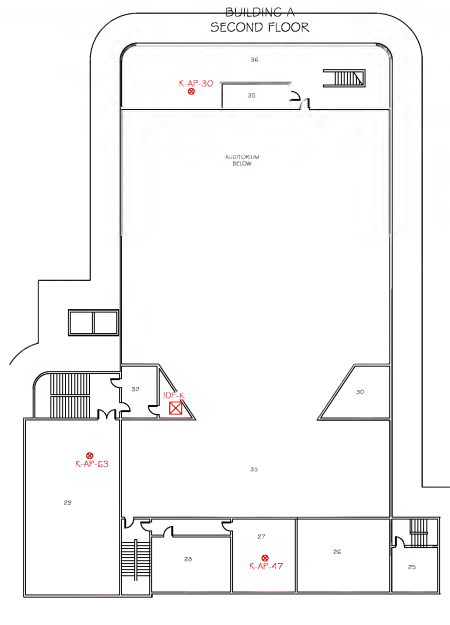

**BUILDING A
FIRST FLOOR**

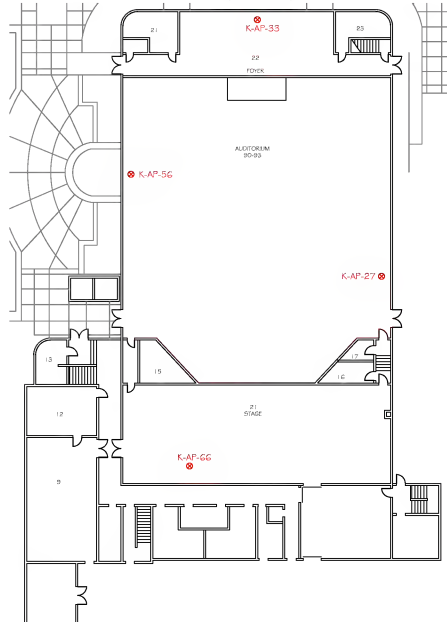

IDF-K - WIRELESS ACCESS POINT PLAN

SCALE: 1/32" = 1'-0"

LEGEND

● WIRELESS ACCESS POINT



PREPARED FOR:
**EL MONTE
UNION HIGH
SCHOOL
DISTRICT**

SITE:
**EL MONTE
HIGH SCHOOL**

3048 TYLER AVE
EL MONTE, CA 91731

**AS-BUILT
PROJECT NO. 5231**

REVISIONS:

DATE DESCRIPTION:

DRAWN BY:

GERARDO MORALES

DATE:

10/9/12

SCALE:

AS SHOWN

SIZE:

11x17

TITLE:

**IDF-L
WIRELESS
ACCESS POINT
PLAN**


PROPERTY OF EASY NETWORKS
NOT TO BE USED BY OTHERS WITHOUT PERMISSION

SHEET #:

T14

14 OF 17

BLDG. M

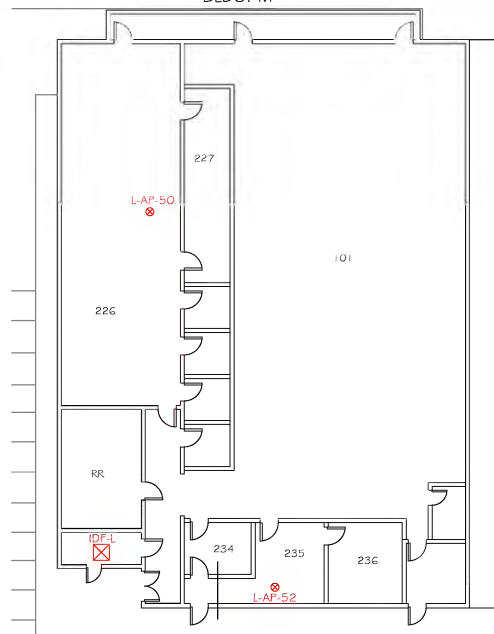

IDF-L - WIRELESS ACCESS POINT PLAN

SCALE: 3/64" = 1'-0"

LEGEND

 **WIRELESS ACCESS POINT**



PREPARED FOR:
**EL MONTE
UNION HIGH
SCHOOL
DISTRICT**

SITE:
**EL MONTE
HIGH SCHOOL**

3048 TYLER AVE
EL MONTE, CA 91731

**AS-BUILT
PROJECT NO. 5231**

REVISIONS:

DATE: **DESCRIPTION:**

DRAWN BY:

GERARDO MORALES

DATE:

10/9/12

SCALE:

AS SHOWN

SIZE:

11x17

TITLE:


**IDF-M
WIRELESS
ACCESS POINT
PLAN**

PROPERTY OF EASY NETWORKS
NOT TO BE USED BY ANY OTHER PERSON OR FIRM

SHEET#:

T15

15 OF 17

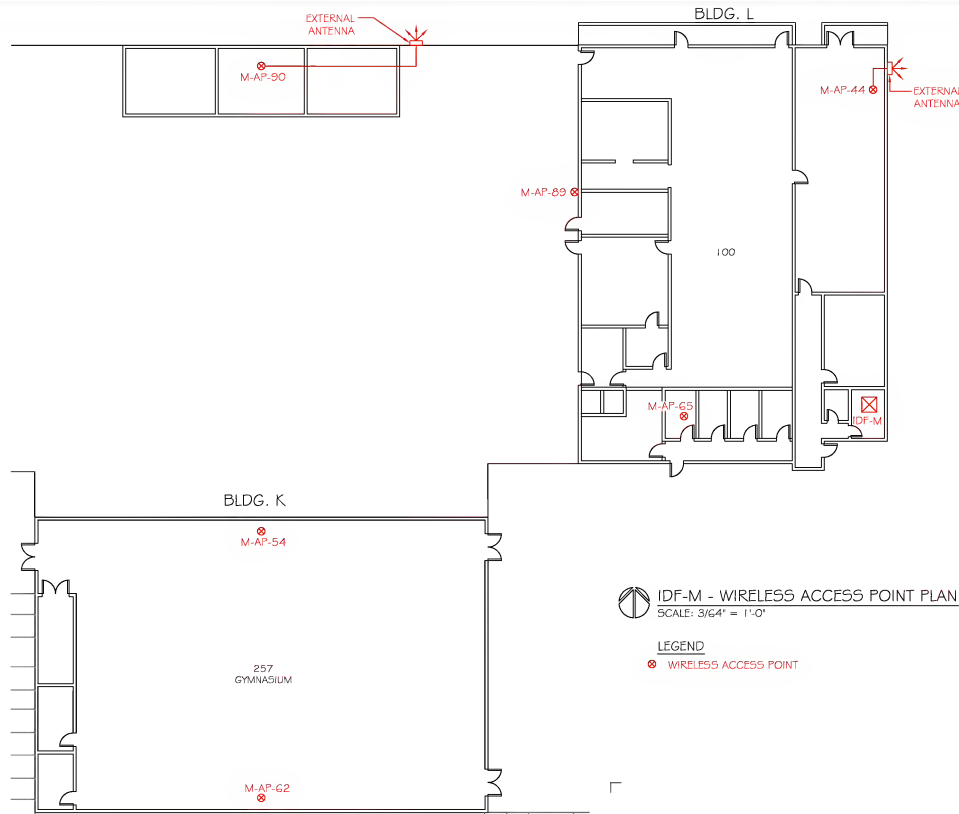

PREPARED FOR:
**EL MONTE
UNION HIGH
SCHOOL
DISTRICT**

SITE:
**EL MONTE
HIGH SCHOOL**

3048 TYLER AVE
EL MONTE, CA 91731

**AS-BUILT
PROJECT NO. 5231**

REVISIONS:

DATE: **DESCRIPTION:**

DRAWN BY:

GERARDO MORALES

DATE:

10/9/12

SCALE:

AS SHOWN

SIZE:

11x17

TITLE:

**IDF-N
WIRELESS
ACCESS POINT
PLAN**


* PROPERTY OF EASY NETWORKS *
* NOT TO BE USED BY ANY OTHER PARTY *
* FOR USE BY EASY NETWORKS ONLY *

SHEET #:

T16

16 OF 17

BLDG. C

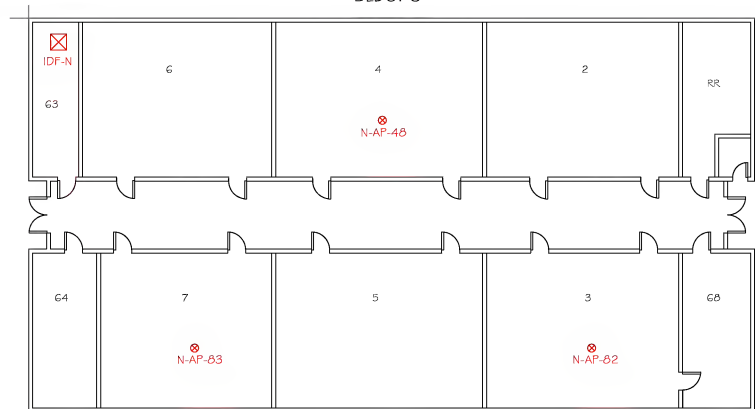

IDF-N - WIRELESS ACCESS POINT PLAN

SCALE: 1/16" = 1'-0"

LEGEND

⊗ WIRELESS ACCESS POINT



PREPARED FOR:
**EL MONTE
UNION HIGH
SCHOOL
DISTRICT**

SITE:
**EL MONTE
HIGH SCHOOL**

3048 TYLER AVE
EL MONTE, CA 91731

**AS-BUILT
PROJECT NO. 5231**

REVISIONS:

DATE DESCRIPTION

DRAWN BY:

GERARDO MORALES

DATE:

10/9/12

SCALE:

AS SHOWN

SHEET:

11 X 17

TITLE:

**IDF-P
WIRELESS
ACCESS POINT
PLAN**

* PROPERTY IS NOT RECORDED *

* NOT USED BY CADD REVISION ONLY *

SHEET #:

T17

17 OF 17



IDF-P - WIRELESS ACCESS POINT PLAN
SCALE: 1/16" = 1'-0"

LEGEND

⊗ WIRELESS ACCESS POINT

LIBRARY &
MEDIA CENTER



EASY NETWORKS - 5231, 10/17/2012 4:41:45 PM, 11 x 17

SCALE: 1/32" = 1' - 0"

 WIRELESS ACCESS POINT

• PROPERTY OF EASY NETWORKS •
• FOR USE BY EASY NETWORK ONLY •

PREPARED FOR:
**EL MONTE
UNION HIGH
SCHOOL
DISTRICT**

SITE:
**FERNANDO
LEDESMA
CONTINUATION
HIGH SCHOOL**

12347 RAMONA BLVD.
EL MONTE, CA 91732

**AS-BUILT
PROJECT NO. 5231**

REVISIONS:

DATE: DESCRIPTION:

DRAWN BY:

GERARDO MORALES

DATE: 10/9/12

SCALE: AS SHOWN

SIZE: 11x17

TITLE:


**MDF & IDF-B
WIRELESS
ACCESS POINT
PLAN**

* PROPERTY OF EASY NETWORKS *
* NOT TO BE USED FOR REPRODUCTION *

SHEET #:

T2

2 OF 5

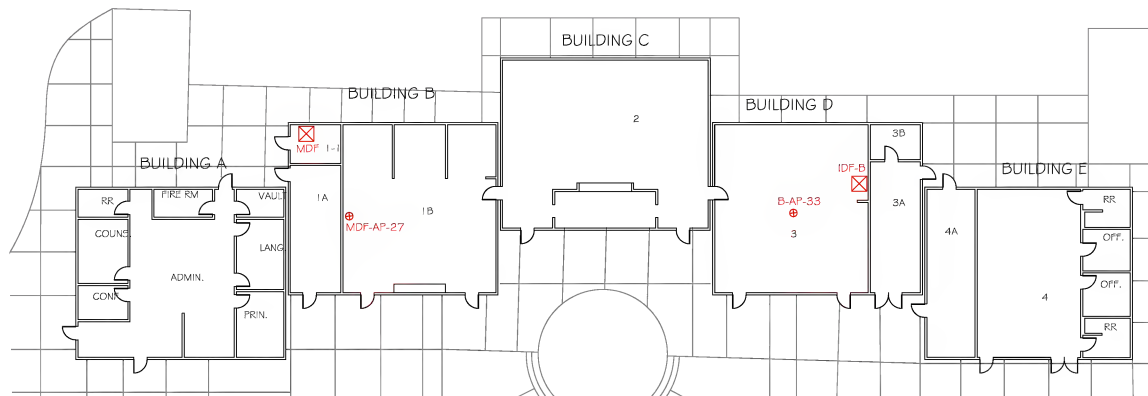

MDF & IDF-B - WIRELESS ACCESS POINT PLAN


SCALE: 3/64" = 1' - 0"

LEGEND



 **WIRELESS ACCESS POINT**



BUILDING F
2ND FLOOR

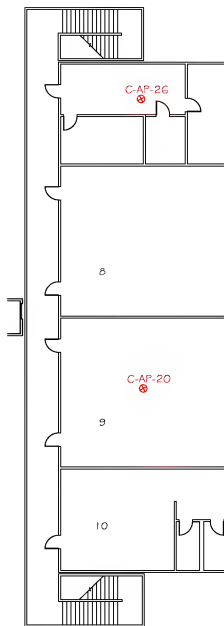

BUILDING F
1ST FLOOR

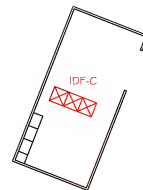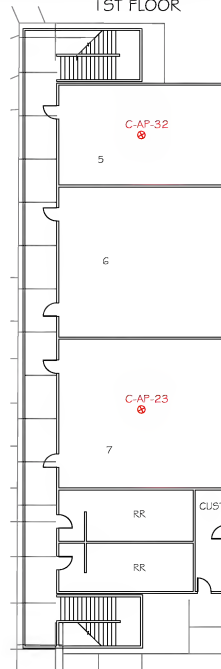


IDF-C - WIRELESS ACCESS POINT PLAN

SCALE: 3/64" = 1' - 0"

LEGEND

⊗ WIRELESS ACCESS POINT

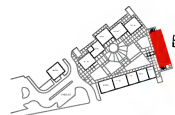

EASYNETWORKS
CABLING

3000 SHELLY WAY
RIVERSIDE, CA 92503
OFFICE: 951-502-8191
FAX: 951-502-8193
ST. LOC: 1-800-770

PREPARED FOR:

**EL MONTE
UNION HIGH
SCHOOL
DISTRICT**

SITE:

**FERNANDO
LEDESMA
CONTINUATION
HIGH SCHOOL**

12347 RAMONA BLVD.
EL MONTE, CA 91732

**AS-BUILT
PROJECT NO. 5231**

REVISIONS:

DATE: DESCRIPTION:

DRAWN BY:

GERARDO MORALES

DATE: 10/9/12

SCALE: AS SHOWN

SIZE: 11x17

TITLE:

**IDF-C
WIRELESS
ACCESS POINT
PLAN**

PROPERTY OF EASY NETWORKS
NOT TO BE USED FOR REPRODUCTION

SHEET #:

T3

3 OF 5

PREPARED FOR:
**EL MONTE
UNION HIGH
SCHOOL
DISTRICT**

SITE:
**FERNANDO
LEDESMA
CONTINUATION
HIGH SCHOOL**

12347 RAMONA BLVD.
EL MONTE, CA 91732

**AS-BUILT
PROJECT NO. 5231**

REVISIONS:

DATE DESCRIPTION:

DRAWN BY:

GERARDO MORALES

DATE:

10/9/12

SCALE:

AS SHOWN

SIZE:

11x17

TITLE:


**IDF-D
WIRELESS
ACCESS POINT
PLAN**

PROPERTY OF EASY NETWORKS
NOT TO BE USED BY ANY OTHER PARTY

SHEET #:

T4

4 OF 5

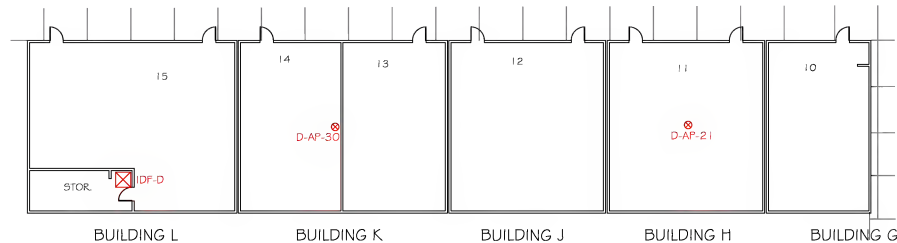


IDF-D - WIRELESS ACCESS POINT PLAN

SCALE: 3/64" = 1' - 0"

LEGEND

⊗ WIRELESS ACCESS POINT

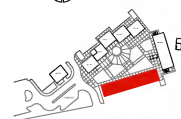

PREPARED FOR:
**EL MONTE
UNION HIGH
SCHOOL
DISTRICT**

SITE:
**FERNANDO
LEDESMA
CONTINUATION
HIGH SCHOOL**

12347 RAMONA BLVD.
EL MONTE, CA 91732

**AS-BUILT
PROJECT NO. 5231**

REVISIONS:

DATE: **DESCRIPTION:**

DRAWN BY:

GERARDO MORALES

DATE:

10/9/12

SCALE:

AS SHOWN

SIZE:

11 x 17

TITLE:

**IDF-E
WIRELESS
ACCESS POINT
PLAN**


• PROPERTY OF EASY NETWORKS •
• NOT TO BE USED FOR REPRODUCTION •

SHEET#:

T5

5 OF 5

BUILDING M

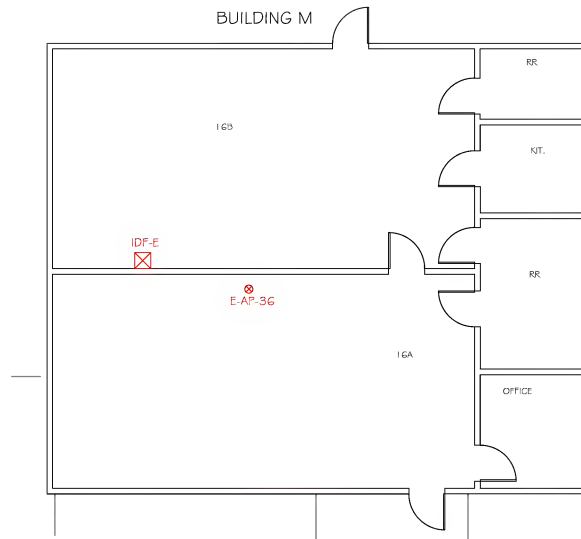


IDF-E - WIRELESS ACCESS POINT PLAN


SCALE: 3/64" = 1' - 0"

LEGEND

• WIRELESS ACCESS POINT

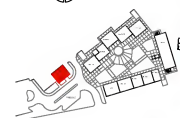

WIRELESS ACCESS POINT SCHEDULE			
AP #	Mac Address	Asset Tag	LOCATION
GR-A-20	00:18F7C0B8	41134	Room 2, NMF
GR-A-21	00:18F7C0B8	41133	Room 4, NMF
GR-A-22	00:18F7C0B8	41132	Room 4, NMF

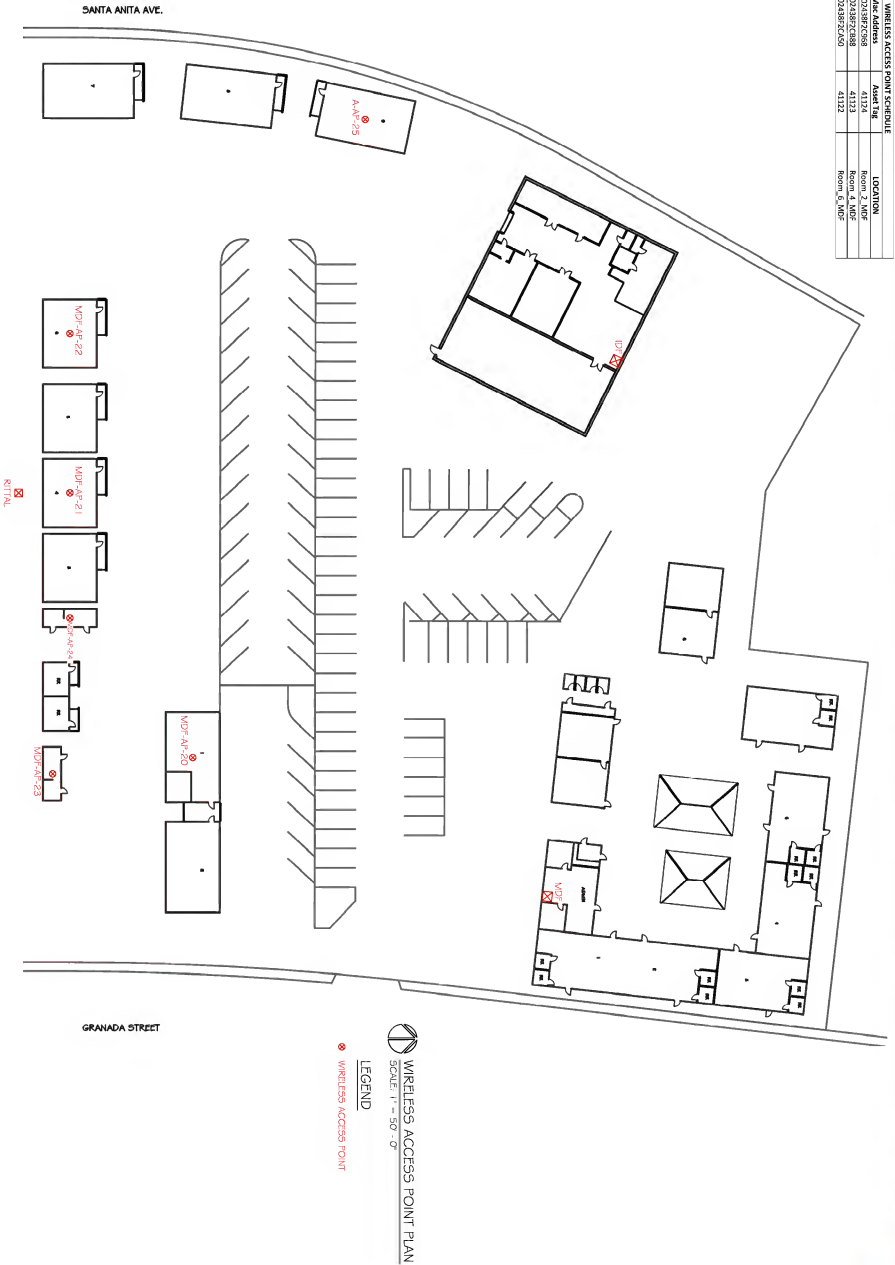

WIRELESS ACCESS POINT PLAN
SCALE: 1" = 50'-0"

LEGEND

WIRELESS ACCESS POINT

PREPARED FOR
EL MONTE
UNION HIGH
SCHOOL
DISTRICT

SITE:
GRANADA
EDUCATION
CENTER
3513 GRANADA AVE.
EL MONTE, CA 91731
AS BUILT
PROJECT NO. 5231

REVISIONS:
DATE: DESCRIPTION:

DRAWN BY:
GERARDO MORALES
DATE: 10/25/12
BY: AS
SCALE: 1/16" = 1'

TITLE:
WIRELESS
ACCESS POINT
PLAN

1 OF 1
SHEET:

EASYNETWORKS
CABLING
10000 E. 15th Ave.
Denver, CO 80231
Tel: 303.755.1100
Fax: 303.755.1101
www.easynetworks.com

PREPARED FOR:
**EL MONTE
UNION HIGH
SCHOOL
DISTRICT**

SITE:
**MOUNTAIN
VIEW
HIGH SCHOOL**

2900 PARKWAY DRIVE
EL MONTE, CA 91732

AS-BUILT
PROJECT NO. 5231

REVISIONS:
DATE DESCRIPTION

DRAWN BY:
GERARDO MORALES

DATE: 10/9/12
SCALE: AS SHOWN
SIZE: 11 X 17

TITLE:
**WIRELESS
ACCESS POINT
PLAN**

* PROPERTY OF EASY NETWORKS
* NOT TO BE USED BY OTHER NETWORKS

SHEET #:

T1

1 OF 12



AP #	Mac Address	Asset Tag	LOCATION
MVH-L2-AP-20	002368030C0C	36345	Portables184
MVH-B-AP-21	002368030C0C	36346	Portables185
MVH-A-AP-22	00236803077C	36655	Adminstration, Bldg-A
MVH-A-AP-23	002368030C74	36339	Teachers'ing, Bldg-A
MVH-MD-AP-24	0023680310B8	36344	Portables
MVH-CL-AP-25	002368030C04	36338	Library, Bldg-C
MVH-CL-AP-26	002368030C08	36327	Library, Bldg-C
MVH-E-AP-27	002368030C04	36327	Room205, Bldg-E
MVH-E-AP-28	002368040E01	36340	Room294, Bldg-E
MVH-E-AP-29	002368030B04	36328	Room301, Bldg-E
MVH-E-AP-30	002368031000	36334	Room302, Bldg-E
MVH-G-AP-31	002368030C08	36323	Student Shore Bldg-G
MVH-G-AP-32	002368030C08	36323	Cafeteria
MVH-G-AP-33	002368030C08	36323	Cafeteria
MVH-G-AP-34	002368030C08	36323	Maintenance, Bldg-G
MVH-G-AP-35	002368030C08	36323	Kitchen
MVH-H-AP-36	002368030B08	36319	Boys Locker, Bldg-H
MVH-H-AP-37	002368030C08	36323	Gym, IDF-H
MVH-H-AP-38	002368030C08	36316	Girls Locker, Bldg-H
MVH-H-AP-39	002368030B08	36315	Gym, Bldg-H
MVH-K-AP-40	002368030B08	36314	Room371, Bldg-K
MVH-K-AP-41	002368030C08	36313	Room371, Bldg-K
MVH-K-AP-42	002368030704	36312	Room355, Bldg-K
MVH-K-AP-43	002368030C08	36311	Room365, Bldg-K
MVH-L1-AP-44	002368030A0C	36382	Room390, Bldg-L
MVH-L1-AP-45	002368030B0C	36337	Room392, Bldg-L
MVH-L2-AP-46	002368030704	36381	Portables208
MVH-L2-AP-47	002368030C08	36348	Room393, Bldg-L
MVH-L2-AP-48	002368031000	36374	Algebra, Bldg-L
MVH-M-AP-49	002368030C08	36375	Room392, Bldg-M
MVH-M-AP-50	002368030B08	36376	Senior Center, Bldg-M
MVH-M-AP-51	00236803039C	36677	Career Center
MVH-M-AP-52	00236803103C	36368	RM608, Bldg-M
MVH-M-AP-53	00236803030B	36329	Room255, Bldg-M
MVH-L1-AP-54	002368030B08	36377	Room395, IDF-L1
MVH-MD-AP-55	002368030C08	36378	Room255, Bldg-M
MVH-MD-AP-56	002368030B0C	36376	Room255, Bldg-M
MVH-MD-AP-57	002368030B0C	36372	Room255, Bldg-M
MVH-MD-AP-58	002368030C0C	36371	Room252, Bldg-M
MVH-MD-AP-59	002368030C0C	36373	Room318, Bldg-M
MVH-CL-AP-60	002368030B04	36200	Room275, IDF-C1

WIRELESS ACCESS POINT PLAN

SCALE: 1" = 30' 0"

LEGEND

● WIRELESS ACCESS POINT

PREPARED FOR:
**EL MONTE
UNION HIGH
SCHOOL
DISTRICT**

SITE:
**MOUNTAIN
VIEW
HIGH SCHOOL**

2900 PARKWAY DRIVE
EL MONTE, CA 91732

**AS-BUILT
PROJECT NO. 5231**

REVISIONS:

DATE: DESCRIPTION:

DRAWN BY:

GERARDO MORALES

DATE:

10/9/12

SCALE:

AS SHOWN

SIZE:

11x17

TITLE:


**MDF
WIRELESS
ACCESS POINT
PLAN**

PROPERTY OF EASY NETWORKS
FOR USE BY TASK NETWORK ONLY

SHEET #:

T2

2 OF 12

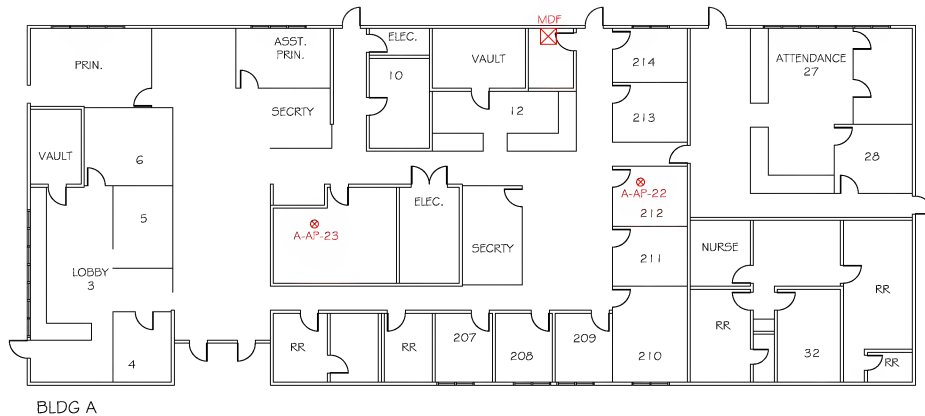

BLDG A



MDF - WIRELESS ACCESS POINT PLAN

SCALE: 1/16" = 1'-0"

LEGEND

⊗ WIRELESS ACCESS POINT



PREPARED FOR:
**EL MONTE
UNION HIGH
SCHOOL
DISTRICT**

SITE:
**MOUNTAIN
VIEW
HIGH SCHOOL**

2900 PARKWAY DRIVE
EL MONTE, CA 91732

**AS-BUILT
PROJECT NO. 5231**

REVISIONS:

DATE: **DESCRIPTION:**

DRAWN BY:

GERARDO MORALES

DATE: 10/9/12

SCALE: AS SHOWN

SIZE: 11x17

TITLE:

**IDF-B
WIRELESS
ACCESS POINT
PLAN**

PROPERTY OF EASY NETWORKS
FOR USE BY EASY NETWORKS ONLY

SHEET #:

T3

3 OF 12



IDF-B - WIRELESS ACCESS POINT PLAN

SCALE: 3/64" = 1'-0"

LEGEND

 **WIRELESS ACCESS POINT**



PREPARED FOR:
**EL MONTE
UNION HIGH
SCHOOL
DISTRICT**

SITE:
**MOUNTAIN
VIEW
HIGH SCHOOL**

2900 PARKWAY DRIVE
EL MONTE, CA 91732

**AS-BUILT
PROJECT NO. 5231**

REVISIONS:

DATE	DESCRIPTION

DRAWN BY:

GERARDO MORALES

DATE:

10/9/12

SCALE:

AS SHOWN

SIZE:

11x17

TITLE:


**IDF-C
WIRELESS
ACCESS POINT
PLAN**

• PROPERTY OF EASY NETWORKS •
• FOR USE BY EASY NETWORKS ONLY •

SHEET #:

T4

4 OF 12

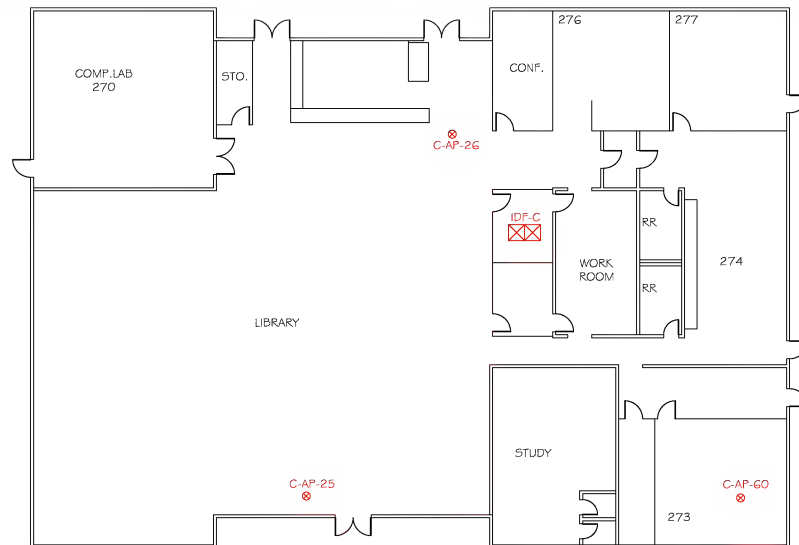

BLDG C



IDF-C - WIRELESS ACCESS POINT PLAN
SCALE: 1/16" = 1'-0"

LEGEND

⊗ WIRELESS ACCESS POINT



PREPARED FOR:
**EL MONTE
UNION HIGH
SCHOOL
DISTRICT**

SITE:
**MOUNTAIN
VIEW
HIGH SCHOOL**

2900 PARKWAY DRIVE
EL MONTE, CA 91732

**AS-BUILT
PROJECT NO. 5231**

REVISIONS:

DATE DESCRIPTION

DRAWN BY:

GERARDO MORALES

DATE:

10/9/12

SCALE:

AS SHOWN

SIZE:

11x17

TITLE:


**IDF-E
WIRELESS
ACCESS POINT
PLAN**

PROPERTY OF EASY NETWORKS
FOR USE BY TASH NETWORK ONLY

SHEET #:

T5

5 OF 12

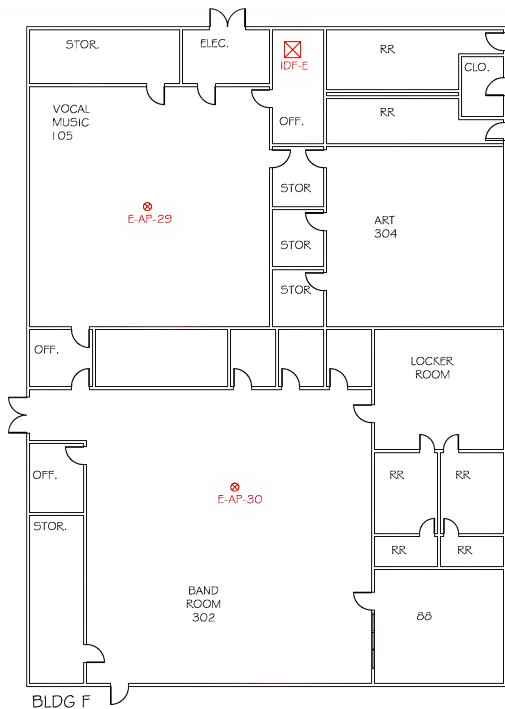


IDF-E - WIRELESS ACCESS POINT PLAN

SCALE: 1/16" = 1'-0"

LEGEND

⊗ WIRELESS ACCESS POINT

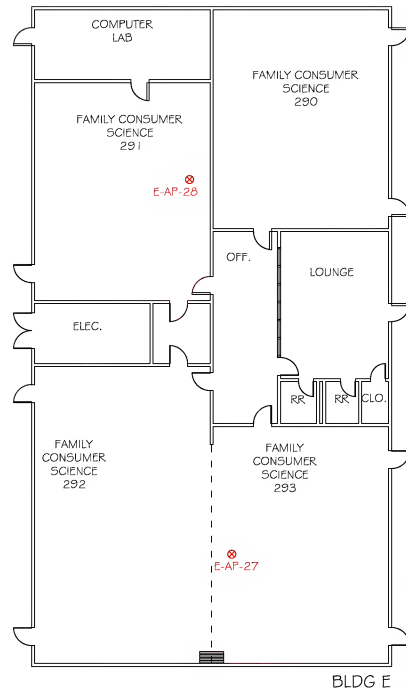

KEYMAP
NTS



PREPARED FOR:
**EL MONTE
UNION HIGH
SCHOOL
DISTRICT**

SITE:
**MOUNTAIN
VIEW
HIGH SCHOOL**

2900 PARKWAY DRIVE
EL MONTE, CA 91732

**AS-BUILT
PROJECT NO. 5231**

REVISIONS:

DATE: **DESCRIPTION:**

DRAWN BY:

GERARDO MORALES

DATE:

10/9/12

SCALE:

AS SHOWN

SIZE:

11 x 17

TITLE:


**IDF-G
WIRELESS
ACCESS POINT
PLAN**

PROPERTY OF EASY NETWORKS
FOR USE BY EASY NETWORKS ONLY

SHEET #:

T6

6 OF 12

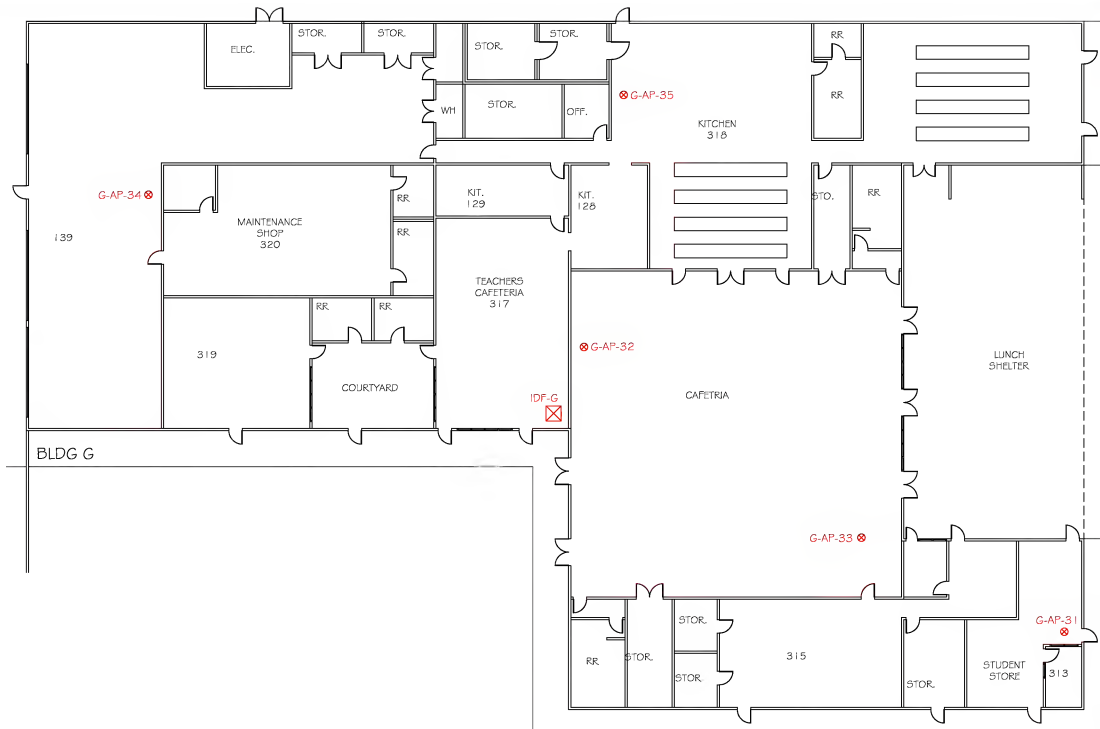

IDF-G - WIRELESS ACCESS POINT PLAN

SCALE: 3/64" = 1'-0"

LEGEND

● WIRELESS ACCESS POINT



KEYMAP
NTS



PREPARED FOR:
**EL MONTE
UNION HIGH
SCHOOL
DISTRICT**

SITE:
**MOUNTAIN
VIEW
HIGH SCHOOL**

2900 PARKWAY DRIVE
EL MONTE, CA 91732

**AS-BUILT
PROJECT NO. 5231**

REVISIONS:

DATE: **DESCRIPTION:**

DRAWN BY:

GERARDO MORALES

DATE:

10/9/12

SCALE:

AS SHOWN

SIZE:

11x17

TITLE:


**IDF-H
WIRELESS
ACCESS POINT
PLAN**

PROPERTY OF EASY NETWORKS
FOR USE BY EASY NETWORKS ONLY

SHEET #:

T7

7 OF 12

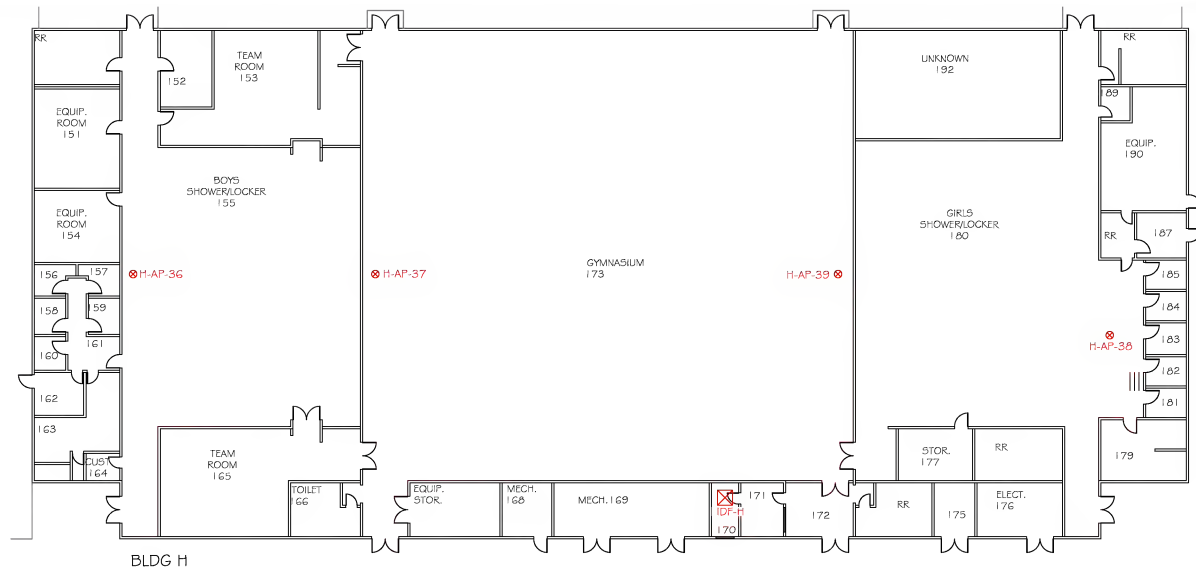

IDF-H - WIRELESS ACCESS POINT PLAN
SCALE: 3/64" = 1'-0"

LEGEND

● WIRELESS ACCESS POINT



PREPARED FOR:
**EL MONTE
UNION HIGH
SCHOOL
DISTRICT**

SITE:
**MOUNTAIN
VIEW
HIGH SCHOOL**

2900 PARKWAY DRIVE
EL MONTE, CA 91732

**AS-BUILT
PROJECT NO. 5231**

REVISIONS:

DATE DESCRIPTION

DRAWN BY:

GERARDO MORALES

DATE:

10/9/12

SCALE:

AS SHOWN

SIZE:

11x17

TITLE:


**IDF-K
WIRELESS
ACCESS POINT
PLAN**

PROPERTY OF EASY NETWORKS
FOR USE BY EASY NETWORKS ONLY

SHEET #:

T8

8 OF 12

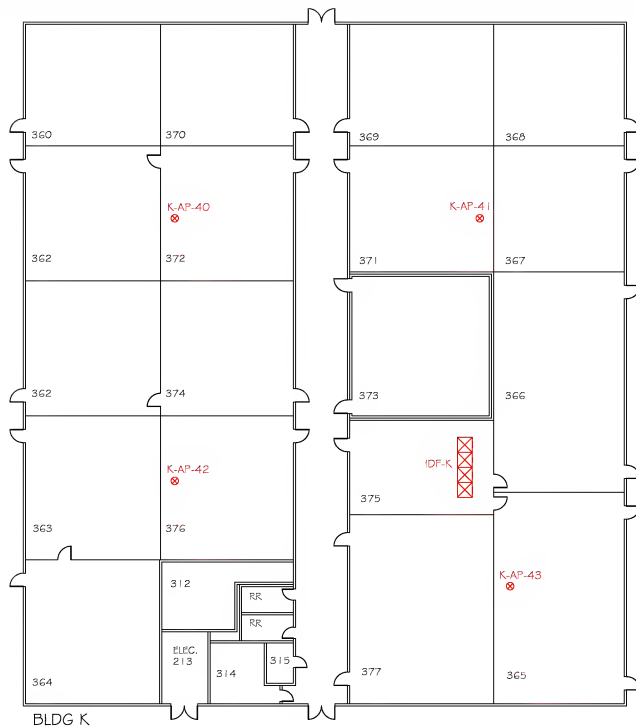

BLDG K



IDF-K - WIRELESS ACCESS POINT PLAN

SCALE: 3/64" = 1'-0"

LEGEND

● WIRELESS ACCESS POINT



PREPARED FOR:
**EL MONTE
UNION HIGH
SCHOOL
DISTRICT**

SITE:
**MOUNTAIN
VIEW
HIGH SCHOOL**

2900 PARKWAY DRIVE
EL MONTE, CA 91732

**AS-BUILT
PROJECT NO. 5231**

REVISIONS:

DATE: DESCRIPTION:

DRAWN BY:

GERARDO MORALES

DATE:

10/9/12

SCALE:

AS SHOWN

SIZE:

11x17

TITLE:


**IDF-L1 & L2
WIRELESS
ACCESS POINT
PLAN**

PROPERTY OF EASY NETWORKS
FOR USE BY EASY NETWORKS ONLY

SHEET #:

T9

9 OF 12

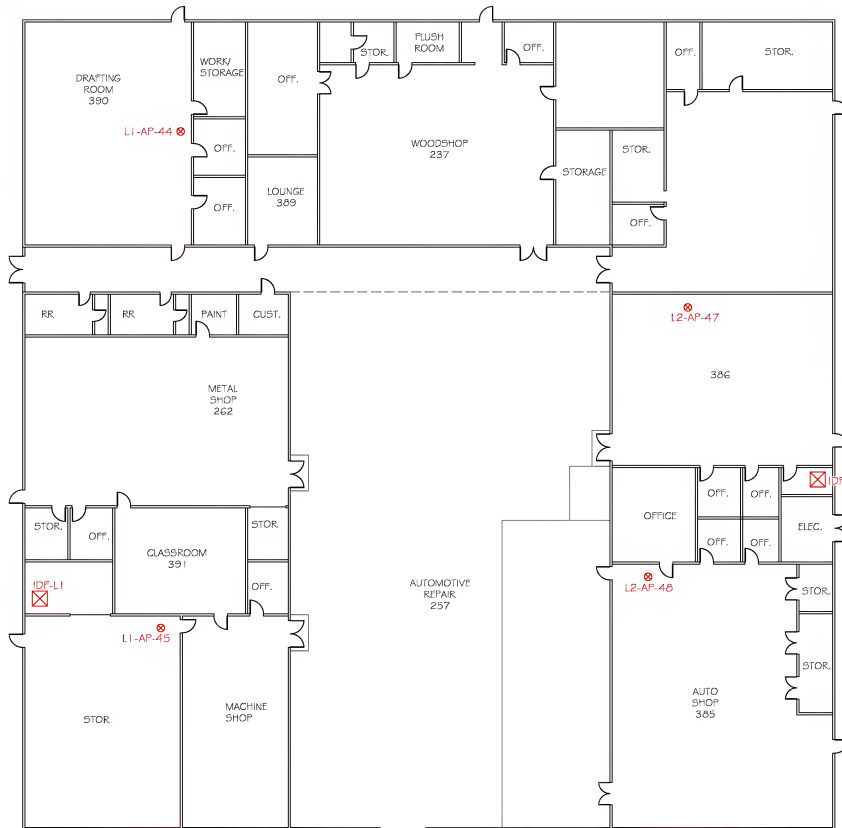

BLDG L



IDF-L1 & L2 - WIRELESS ACCESS POINT PLAN

SCALE: 3/64" = 1'-0"

LEGEND

● WIRELESS ACCESS POINT



PREPARED FOR:
**EL MONTE
UNION HIGH
SCHOOL
DISTRICT**

SITE:
**MOUNTAIN
VIEW
HIGH SCHOOL**

2900 PARKWAY DRIVE
EL MONTE, CA 91732

**AS-BUILT
PROJECT NO. 5231**

REVISIONS:

DATE DESCRIPTION

DRAWN BY:

GERARDO MORALES

DATE: 10/9/12

SCALE: AS SHOWN

SIZE: 11x17

TITLE:




**IDF-M
WIRELESS
ACCESS POINT
PLAN**

PROPERTY OF EASY NETWORKS
FOR USE BY EASY NETWORKS ONLY

SHEET #:

T10

10 OF 12

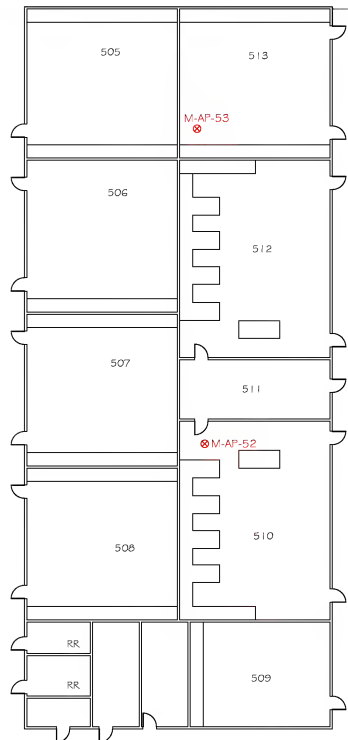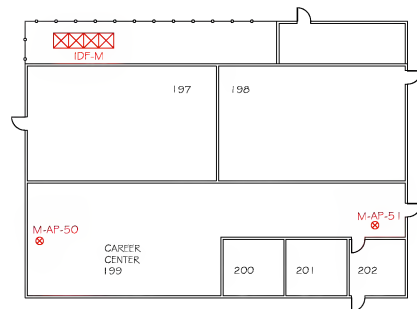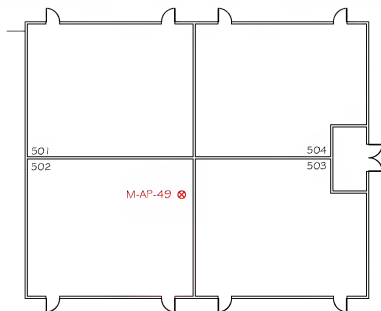

IDF-M - WIRELESS ACCESS POINT PLAN
SCALE: 3/64" = 1'-0"

LEGEND

⊗ WIRELESS ACCESS POINT



**KEYMAP
NTS**



PREPARED FOR:
**EL MONTE
UNION HIGH
SCHOOL
DISTRICT**

SITE:
**MOUNTAIN
VIEW
HIGH SCHOOL**

2900 PARKWAY DRIVE
EL MONTE, CA 91732

**AS-BUILT
PROJECT NO. 5231**

REVISIONS:

DATE: DESCRIPTION:

DRAWN BY:
GERARDO MORALES

DATE: 10/9/12

SCALE: AS SHOWN

SIZE: 11x17

TITLE:



**IDF-M2
WIRELESS
ACCESS POINT
PLAN**

• PROPERTY OF EASY NETWORKS •
• FOR USE BY TASK NETWORK ONLY •

SHEET #:

T 11

11 OF 12

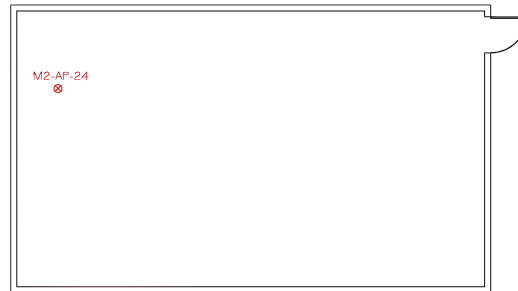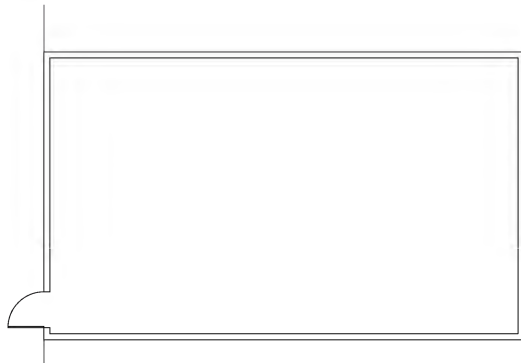

M2-AP-24



IDF-M2



IDF-M2 - WIRELESS ACCESS POINT PLAN

SCALE: 1/8" = 1'-0"

LEGEND

 **WIRELESS ACCESS POINT**



PREPARED FOR:
**EL MONTE
UNION HIGH
SCHOOL
DISTRICT**

SITE:
**MOUNTAIN
VIEW
HIGH SCHOOL**

2900 PARKWAY DRIVE
EL MONTE, CA 91732

**AS-BUILT
PROJECT NO. 5231**

REVISIONS:

DATE: DESCRIPTION:

DRAWN BY:

GERARDO MORALES

DATE: 10/9/12

SCALE: AS SHOWN

SIZE: 11x17

TITLE:


**IDF-R
WIRELESS
ACCESS POINT
PLAN**

• PROPERTY OF EASY NETWORKS •
• 100% USE BY EASY NETWORKS ONLY •

SHEET #:

T12

12 OF 12

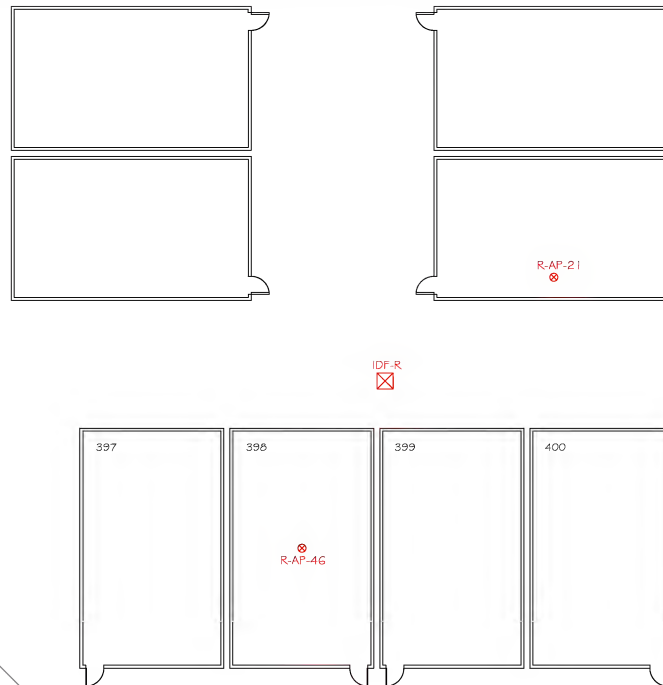

IDF-R - WIRELESS ACCESS POINT PLAN

SCALE: 1/8" = 1'-0"


LEGEND

⊗ WIRELESS ACCESS POINT



**KEYMAP
NTS**



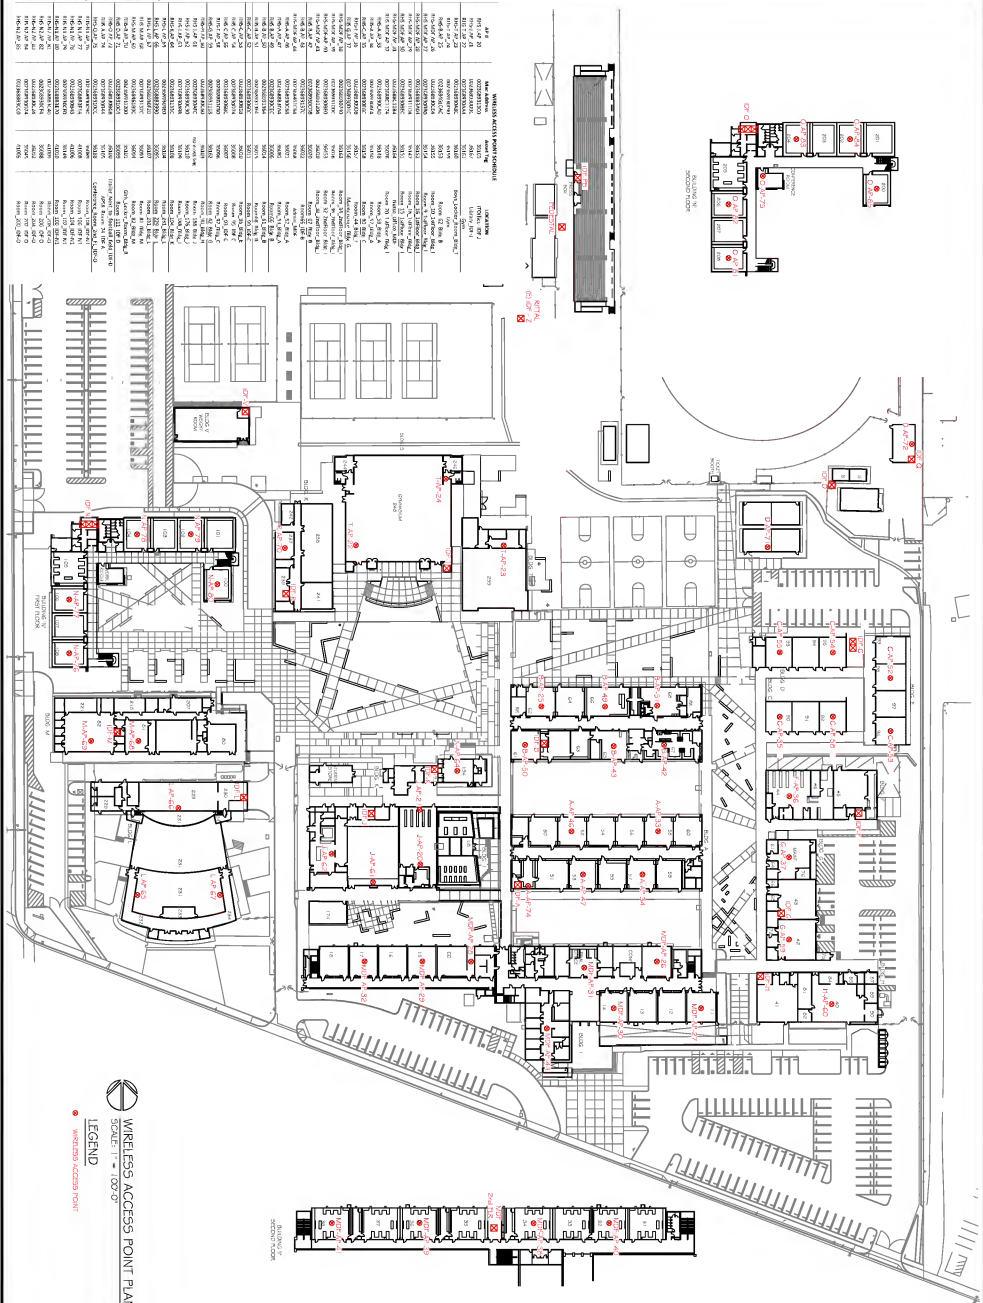

PREPARED FOR:
EL MONTE
UNION HIGH
SCHOOL
DISTRICT

SITE:
ROSEMEAD
HIGH SCHOOL

9063 MISSION DRIVE
ROSEMEAD, CA 91778

AS-BUILT
PROJECT NO. 5231

REVISIONS:



DRAWN BY:
GERARDO MORALES

DATE: 10/9/1
SCALE: AS SHOW
SIZE: 11X1

WIRELESS ACCESS POINT PLAN


SHEET#

T1	1
DF	17

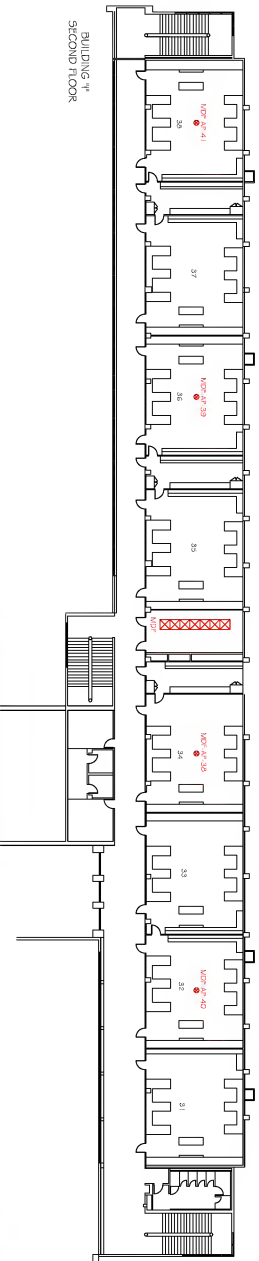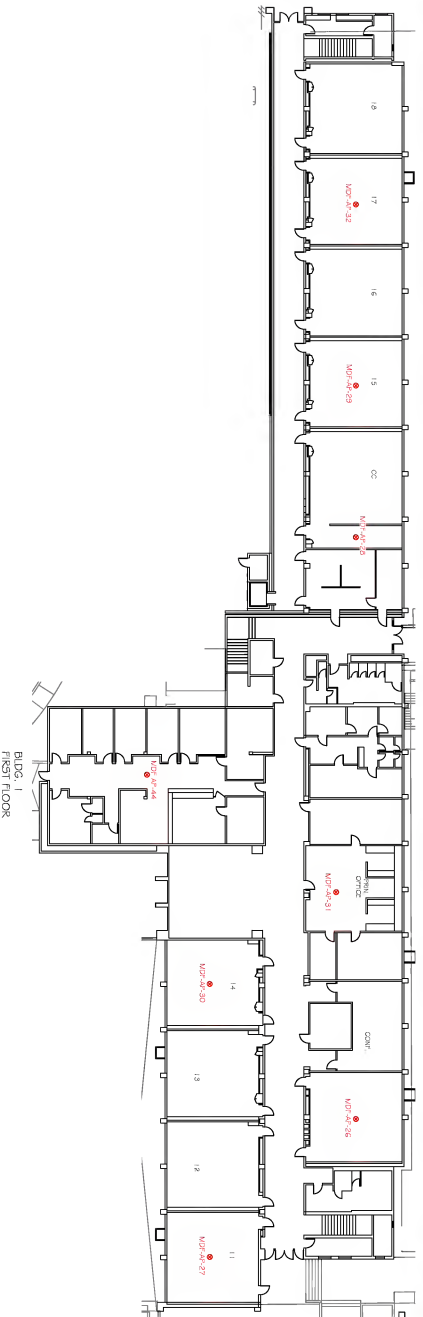

MDF - WIRELESS ACCESS POINT PLAN
SCALE: 1/8" = 1'-0"

LEGEND
● WIRELESS ACCESS POINT

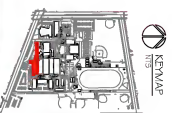

PREPARED FOR
EL MONTE
UNION HIGH
SCHOOL
DISTRICT

SITE
ROSEMEAD
HIGH SCHOOL

4001 MISSION DRIVE
ROSEMEAD, CA 91770

AS BUILT
PROJECT NO. 5231

NO. 5231
DATE: 10/17/2012

DRAWN BY:
BERNARD MORALES


DATE: 10/17/2012
SCALE: AS SHOWN
SIZE: 11x17

TITLE:
MDF
WIRELESS
ACCESS
POINT
PLAN

SHEET:
2 OF 17

EASYNETWORKS
CABLING


3000 S. GATEWAY DRIVE
OCEANOGRAPHY, CA 94068
TEL: 415.363.8888
WWW.EASYNETWORKS.COM

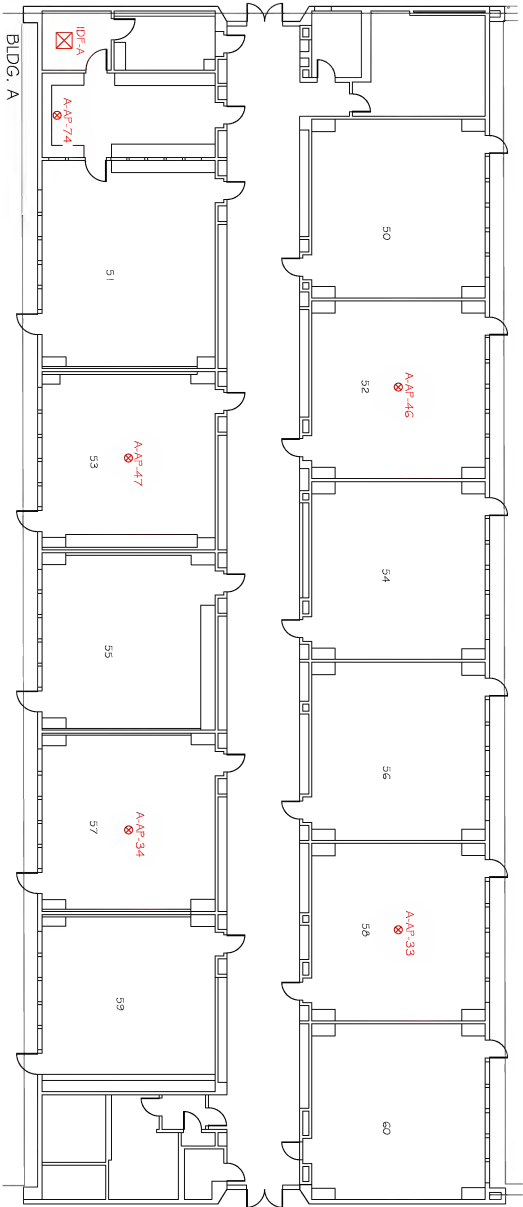

IDF-A - WIRELESS ACCESS POINT PLAN
SCALE: 1/16" = 1'-0"

LEGEND

⊗ WIRELESS ACCESS POINT

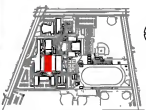

PREPARED FOR:
EL MONTE
UNION HIGH
SCHOOL
DISTRICT

SITE:
ROSEMEAD
HIGH SCHOOL

4003 MISSION DRIVE
ROSEMEAD, CA 91770
AS BUILT
PROJECT NO. 5231

PROJECT NO.:
DATE: DESCRIPTION:


DRAWN BY:
BERARDO MORALES
DATE: 10/20/12
SCALE: AS SHOWN
SIZE: 11x17

TITLE: IDF-A
WIRELESS
ACCESS POINT
PLAN

SHEET#:


T3

3 OF 17

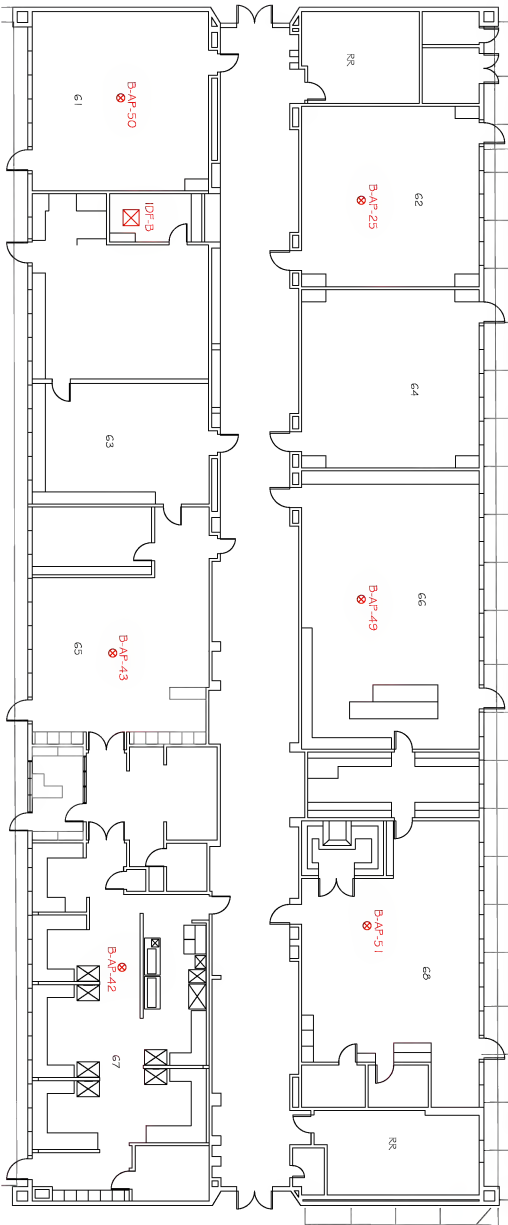

IDF-B - WIRELESS ACCESS POINT PLAN
SCALE: 1/16" = 1'-0"

WIRELESS ACCESS POINT

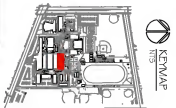

EASYNETWORKS
CABLING
DESIGN & INSTALLATION
SERVICES
10000 N. 10TH AVE.
SUITE 100
DENVER, CO 80231
TEL: 303.755.1111
WWW.EASYNETWORKS.COM

PREPARED FOR:
**EL MONTE
UNION HIGH
SCHOOL
DISTRICT**


SITE:
**ROSEMEAD
HIGH SCHOOL**
1000 MISSION DRIVE
ROSEMEAD, CA 91769
AS BUILT
PROJECT NO. 5231

NO. & DATE	DESCRIPTION

DRAWN BY:	GERARDO MORALES
DATE:	10/20/12
SCALE:	AS SHOWN
SHEET:	11x17

TITLE: **IDF-B
WIRELESS
ACCESS POINT
PLAN**


SHEET#:

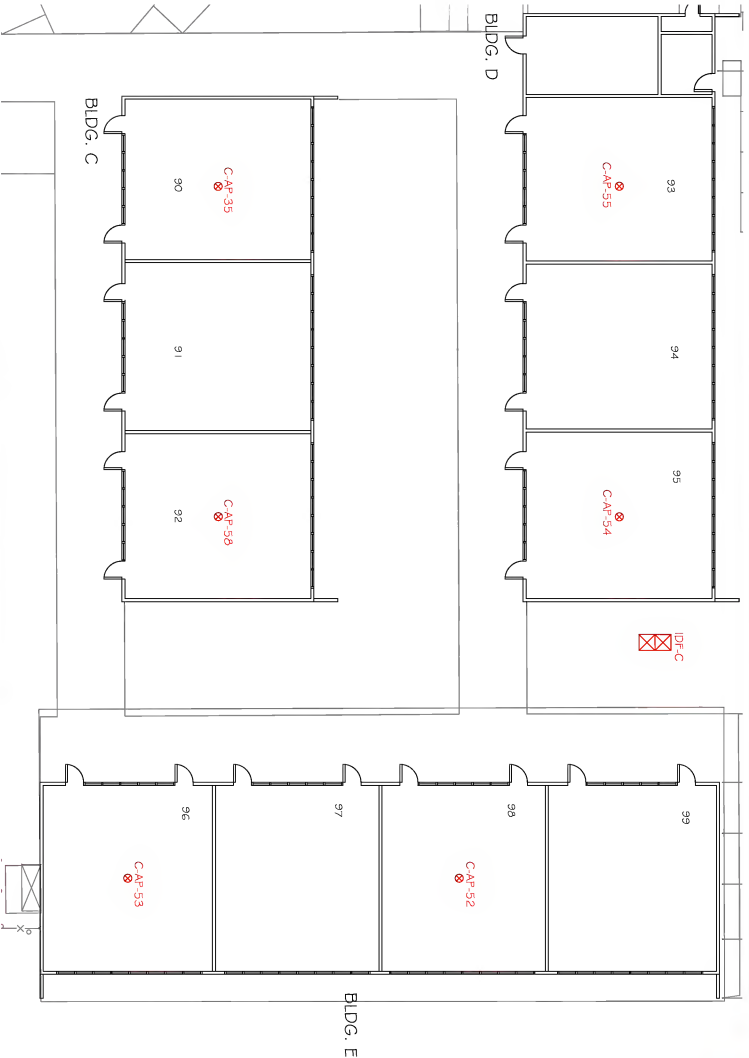

IDF-C - WIRELESS ACCESS POINT PLAN
SCALE: 1/16" = 1'-0"

LEGEND

⊗ WIRELESS ACCESS POINT

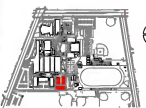

EASYNETWORKS
CABLING
10000 N. 10TH AVENUE
SUITE 100, DENVER, CO 80231
TEL: 303.755.1100
WWW.EASYNETWORKS.COM

PREPARED FOR:
**EL MONTE
UNION HIGH
SCHOOL
DISTRICT**

SITE:
**ROSEMEAD
HIGH SCHOOL**


4001 WILSON DRIVE
ROSEMEAD, CA 91770
AS BUILT
PROJECT NO. 5231

PROVIDING:
DATE: DESCRIPTION:

DRAWN BY:
GERARDO MORALES
DATE: 10/20/12
SCALE: AS SHOWN
SIZE: 11x17


TITLE:
**IDF-C -
WIRELESS
ACCESS POINT
PLAN**


SHEET#:
T5

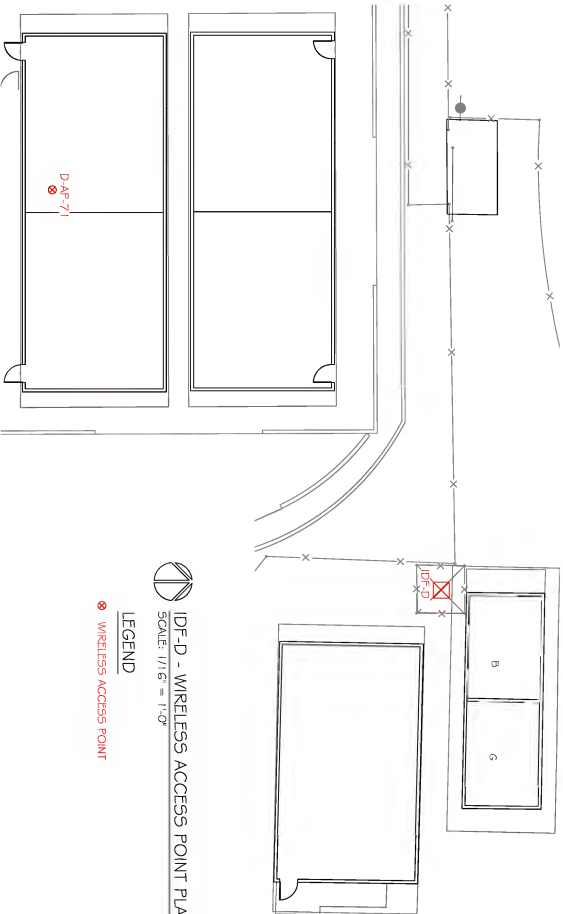

 IDF-D - WIRELESS ACCESS POINT PLAN
SCALE: 1/16" = 1'-0"

 WIRELESS ACCESS POINT

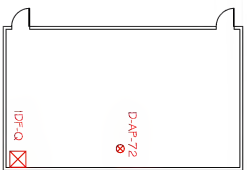


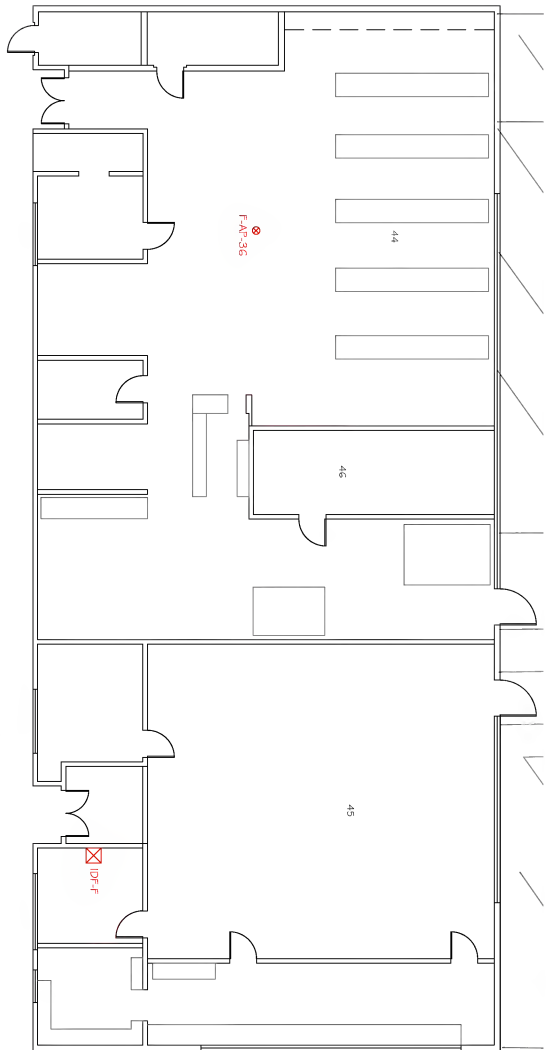

IDF-F - WIRELESS ACCESS POINT PLAN
SCALE: 3/32" = 1'-0"

LEGEND

⊗ WIRELESS ACCESS POINT

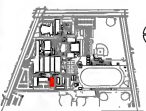

PREPARED FOR:
**EL MONTE
UNION HIGH
SCHOOL
DISTRICT**

SITE:
**ROSEMEAD
HIGH SCHOOL**

4001 WILSON DRIVE
ROSEMEAD, CA 91770

AS BUILT
PROJECT NO. 5231

REV. NO. 001

DATE: 08/08/12

DRAWN BY:
GERARDO MORALES

DATE: 10/07/12

SCALE: AS SHOWN


SIZE: 11x17

TITLE:
**IDF-F
WIRELESS
ACCESS
POINT
PLAN**

SHEET#:

T7


7 OF 17

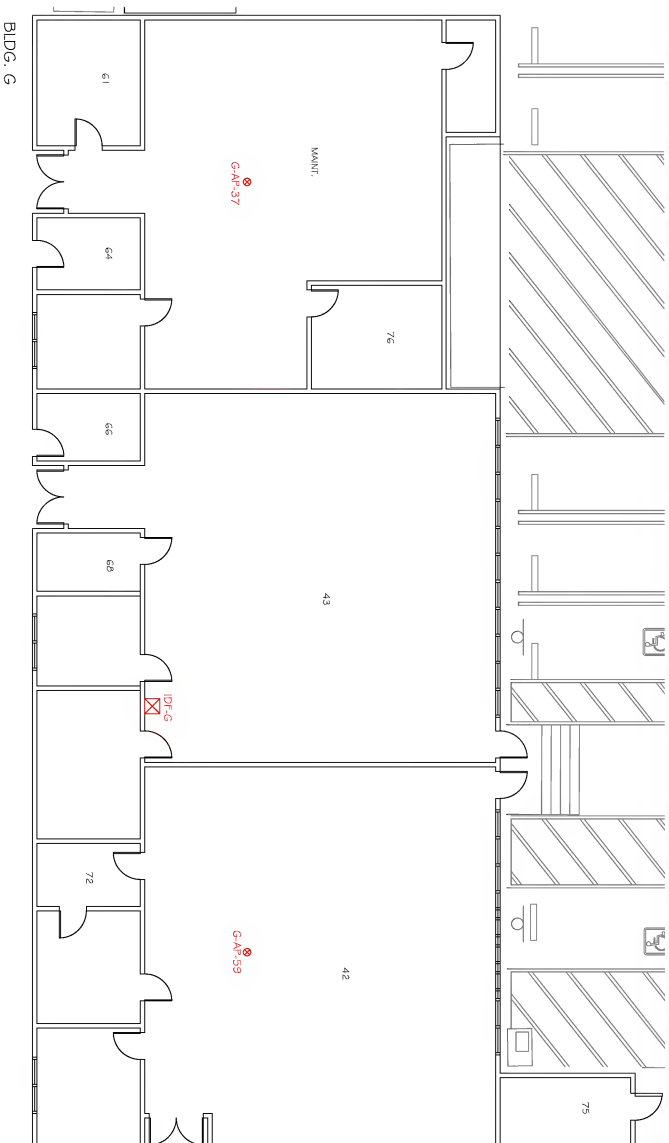

IDF-G - WIRELESS ACCESS POINT PLAN
SCALE: 3/32" = 1'-0"

LEGEND

● WIRELESS ACCESS POINT

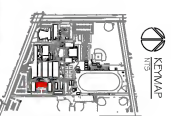

EASYNETWORKS
CABLING
SOLUTIONS
DESIGN, INSTALLATION
AND MAINTENANCE
SERVICES
1-800-850-8500
WWW.EASYNETWORKS.COM

PREPARED FOR
**EL MONTE
UNION HIGH
SCHOOL
DISTRICT**

SITE:
**ROSEMEAD
HIGH SCHOOL**

4003 MISSION DRIVE
ROSEMEAD, CA 91770
AS BUILT
PROJECT NO. 5231

PROJECT NO.:
DATE: DESCRIPTION:


DRAWN BY:
GERARDO MORALES

DATE: 10/20/12
SCALE: AS SHOWN
SIZE: 11x17

TITLE:
**IDF-G
WIRELESS
ACCESS POINT
PLAN**

SHEET#:
T8

8 OF 17

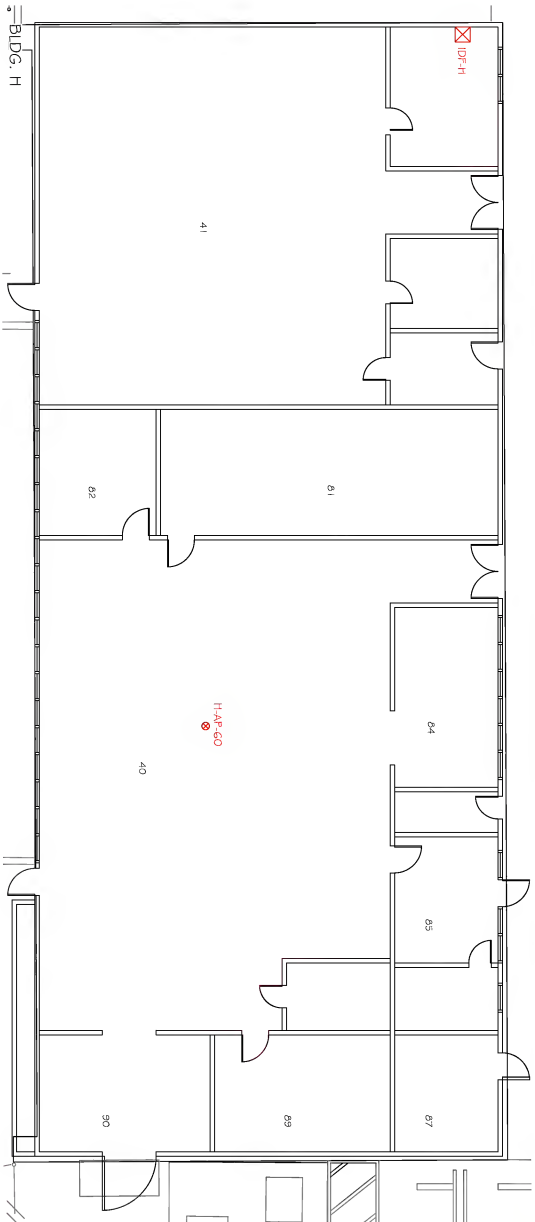

IDF-H - WIRELESS ACCESS POINT PLAN
SCALE: 3/32" = 1'-0"

LEGEND

❌ WIRELESS ACCESS POINT



PREPARED FOR:
**EL MONTE
UNION HIGH
SCHOOL
DISTRICT**

SITE:
**ROSEMEAD
HIGH SCHOOL**


1003 WILSON DRIVE
ROSEMEAD, CA 91770
AS BUILT
PROJECT NO. 5231

REV. NO. 001
DATE: 05/01/2012
DESCRIPTION: 1003 WILSON DRIVE

DRAWN BY:
GERARDO MORALES
DATE: 10/05/12
SCALE: AS SHOWN
SIZE: 11x17

TITLE:
**IDF-H
WIRELESS
ACCESS POINT
PLAN**


SHEET#:
T9

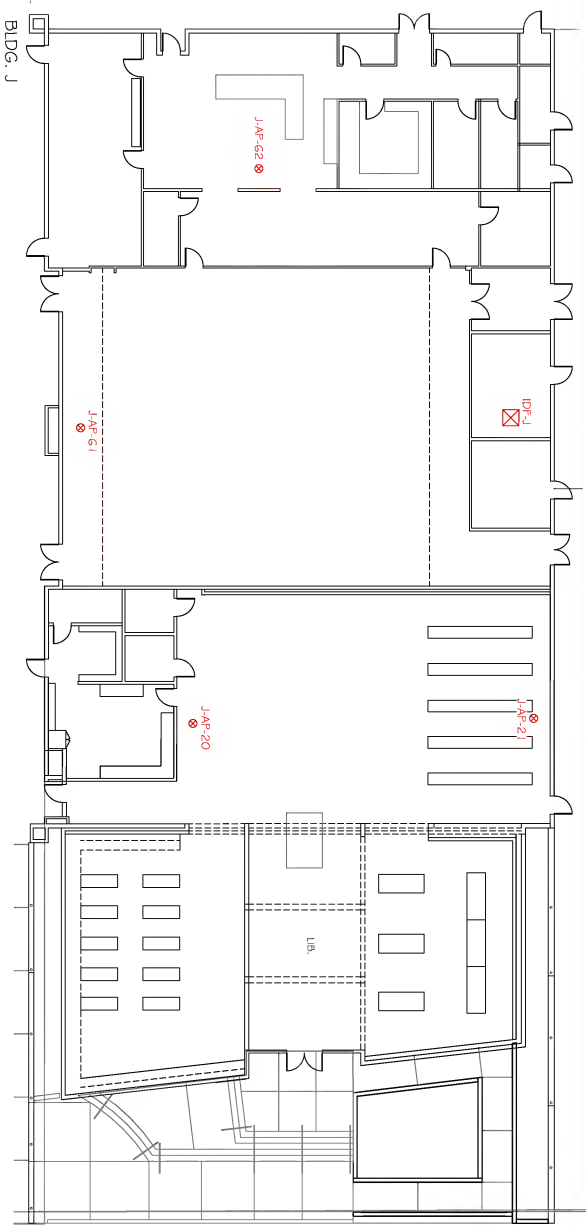

IDF-J - WIRELESS ACCESS POINT PLAN
SCALE: 1/16" = 1'-0"

LEGEND

⊗ WIRELESS ACCESS POINT

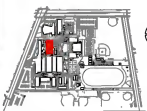

PREPARED FOR
**EL MONTE
UNION HIGH
SCHOOL
DISTRICT**

SITE
**ROSEMEAD
HIGH SCHOOL**


4005 MISSION DRIVE
ROSEMEAD, CA 91770
AS BUILT
PROJECT NO. 5231

PROVIDING:
DATE: DESCRIPTION:

DRAWN BY:
GERARDO MORALES
DATE: 10/20/12
SCALE: AS SHOWN
SIZE: 11x17

TITLE:
**IDF-J
WIRELESS
ACCESS
POINT
PLAN**

SHEET#:
T10
10 OF 17

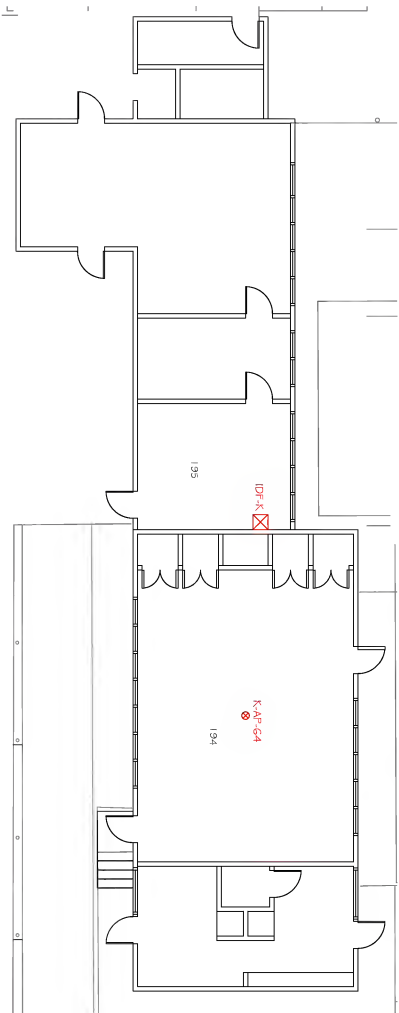

IDF-K - WIRELESS ACCESS POINT PLAN
SCALE: 3/32" = 1'-0"

LEGEND

⊗ WIRELESS ACCESS POINT



PREPARED FOR:
EL MONTE
UNION HIGH
SCHOOL
DISTRICT

SITE:
ROSEMEAD
HIGH SCHOOL

4003 WILSON BLVD
ROSEMEAD, CA 91770
AS BUILT
PROJECT NO. 5231


PROJECT NO.:
DATE: DESCRIPTION:

DRAWN BY:
GERARDO MORALES
DATE: 10/20/12
SCALE: AS SHOWN
SIZE: 11x17

TITLE:
IDF-K
WIRELESS
ACCESS
POINT
PLAN

SHEET#:
T11

11 OF 17

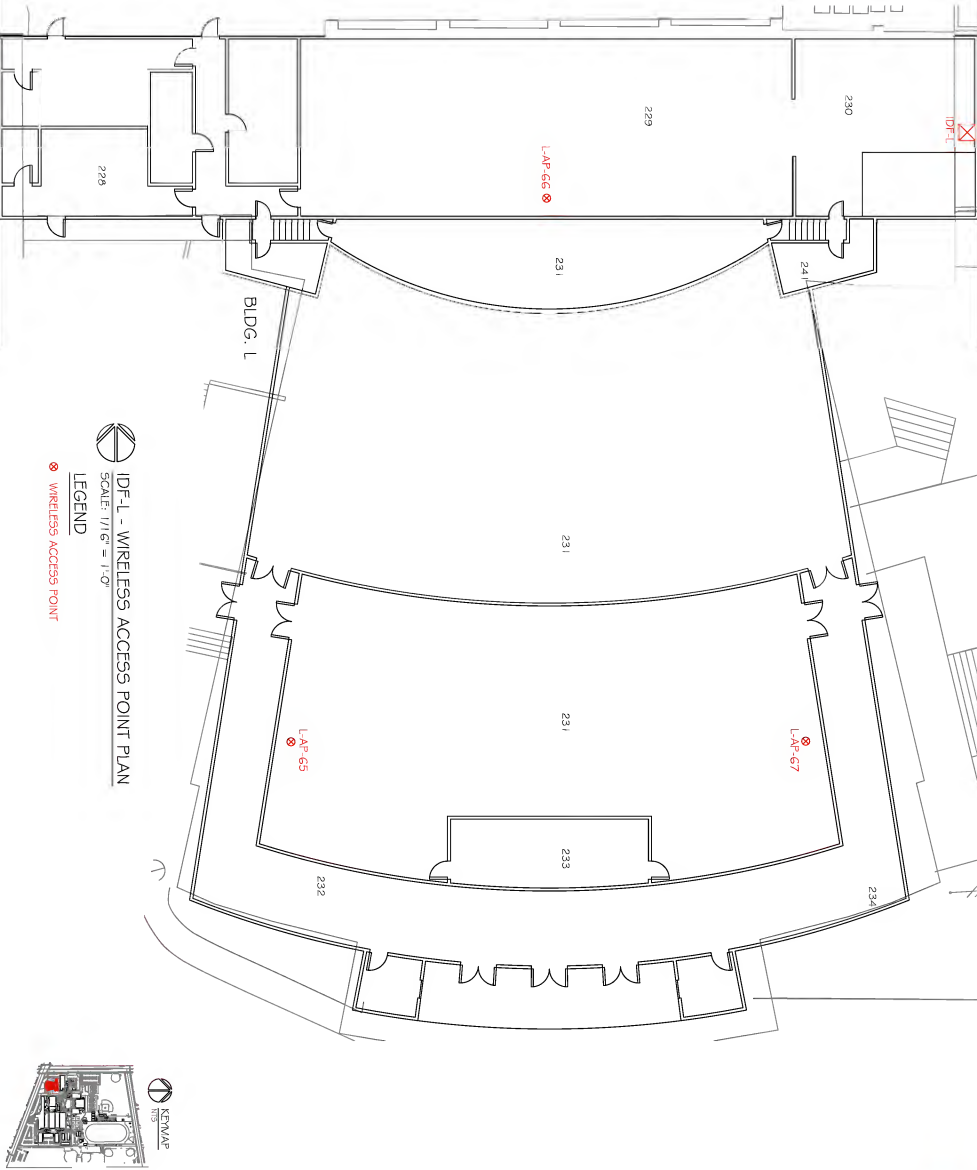

PREPARED FOR:
**EL MONTE
UNION HIGH
SCHOOL
DISTRICT**

SITE:
**ROSEMEAD
HIGH SCHOOL**


4003 MISSION DRIVE
ROSEMEAD, CA 91770
AS BUILT
PROJECT NO. 5231

REVISIONS:
DATE: DESCRIPTION:

DRAWN BY:
GERARDO MORALES
DATE: 10/20/12
SCALE: AS SHOWN
SIZE: 11x17

TITLE:
**IDF-L
WIRELESS
ACCESS
POINT
PLAN**

SHEET#:
T12
12 OF 17

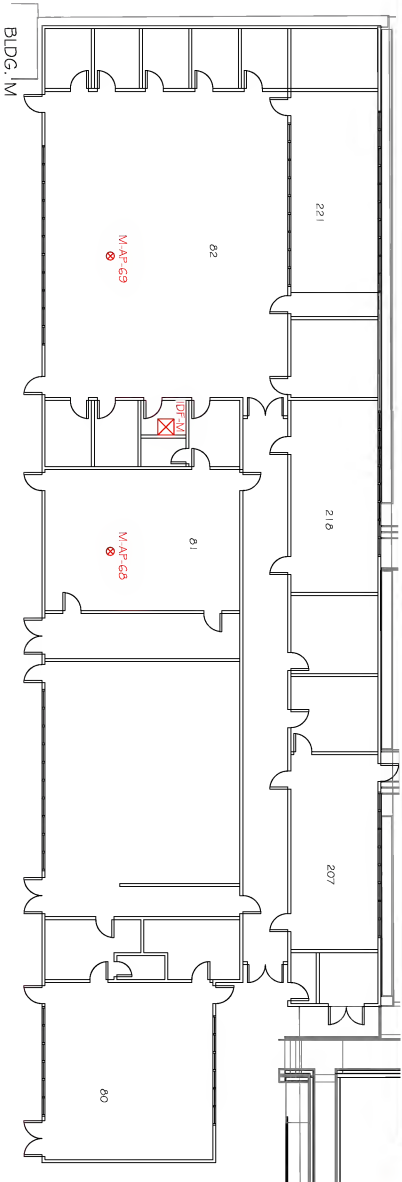

IDF-M - WIRELESS ACCESS POINT PLAN
SCALE: 1/16" = 1'-0"

WIRELESS ACCESS POINT



PREPARED FOR:
**EL MONTE
UNION HIGH
SCHOOL
DISTRICT**


SITE:
**ROSEMEAD
HIGH SCHOOL**

10000 N. 10TH AVE.
SUITE 100
DENVER, CO 80231
TEL: 303.755.1111
WWW.EASYNETWORKS.COM
AS BUILT
PROJECT NO. 5231

REVISIONS:
DATE DESCRIPTION:

DRAWN BY:
GERARDO MORALES
DATE: 10/25/12
SCALE: AS SHOWN
SIZE: 11x17


TITLE:
**IDF-M
WIRELESS
ACCESS
POINT
PLAN**

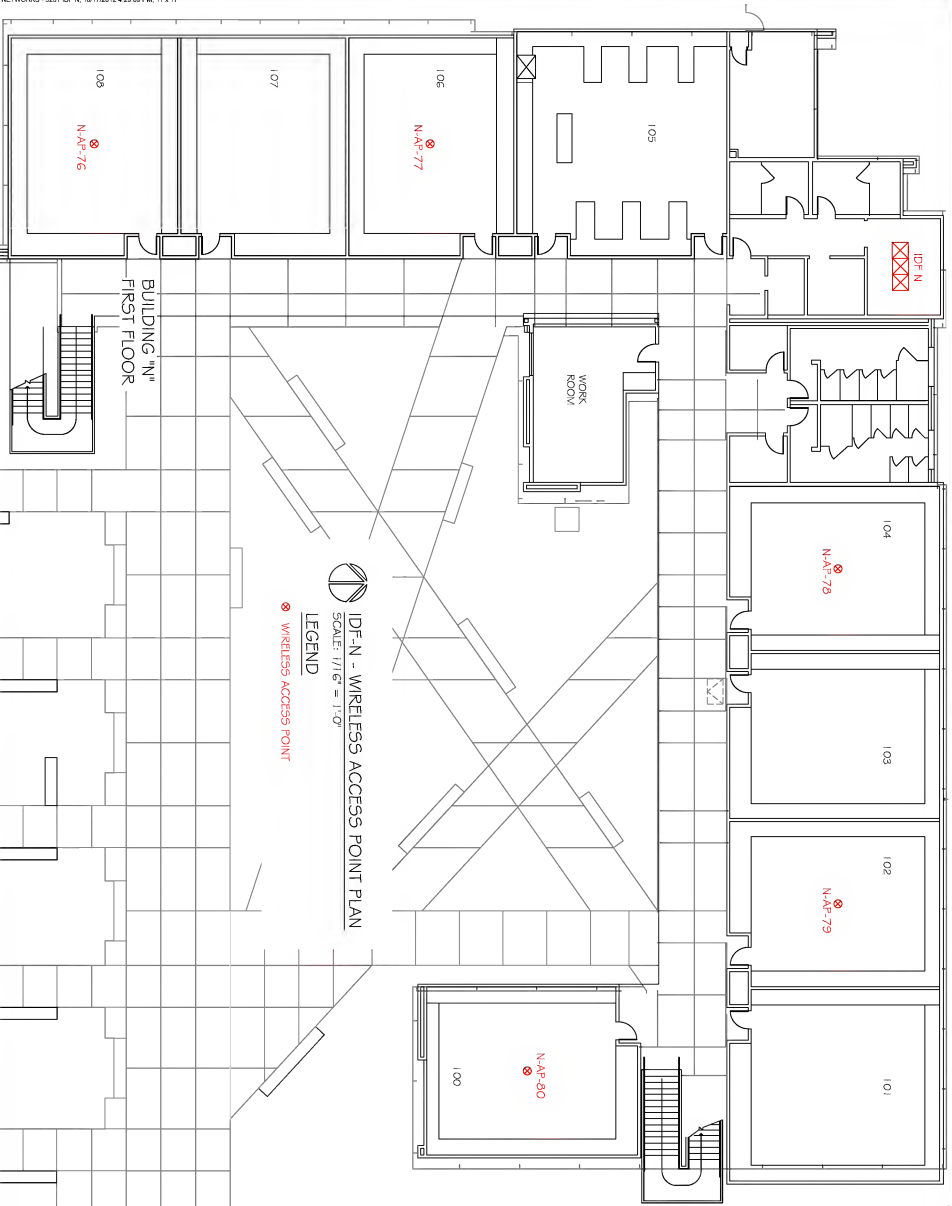

IDF-N - WIRELESS ACCESS POINT PLAN
SCALE: 1/1" = 1'-0"

LEGEND

⊗ WIRELESS ACCESS POINT

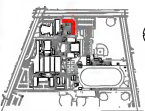

PREPARED FOR:
EL MONTE
UNION HIGH
SCHOOL
DISTRICT

SITE:
ROSEMEAD
HIGH SCHOOL

4005 MISSION DRIVE
ROSEMEAD, CA 91770
AS BUILT
PROJECT NO. 5231


PROVIDING:
DATE: DESCRIPTION:

DRAWN BY:
GERARDO MORALES

DATE: 10/07/12
SCALE: AS SHOWN
SIZE: 11x17

TITLE:
IDF-N
WIRELESS
ACCESS
POINT
PLAN


T14
14 OF 17

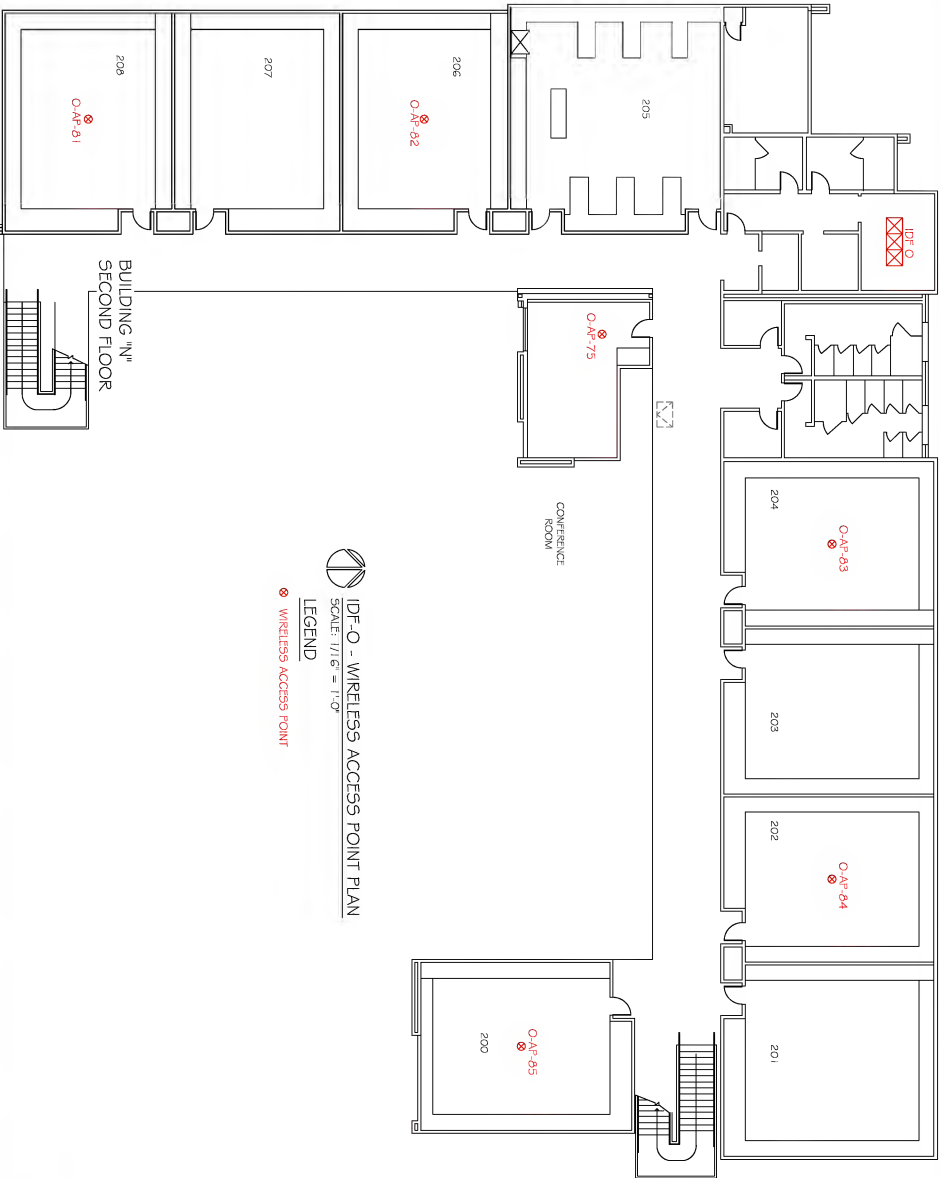

IDF O - WIRELESS ACCESS POINT PLAN
SCALE: 1/16" = 1'-0"

LEGEND

⊗ WIRELESS ACCESS POINT

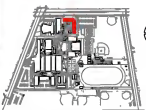

PREPARED FOR:
**EL MONTE
UNION HIGH
SCHOOL
DISTRICT**

SITE:
**ROSEMEAD
HIGH SCHOOL**


1003 WILSON DRIVE
ROSEMEAD, CA 91770
AS BUILT
PROJECT NO. 5231

NO.	REVISIONS:
DATE:	DESCRIPTION:

DRAWN BY:	GERARDO MORALES
DATE:	10/07/12
SCALE:	AS SHOWN
SIZE:	11x17

TITLE:
**IDF O -
WIRELESS
ACCESS
POINT
PLAN**

SHEET#:
T15
15 OF 17

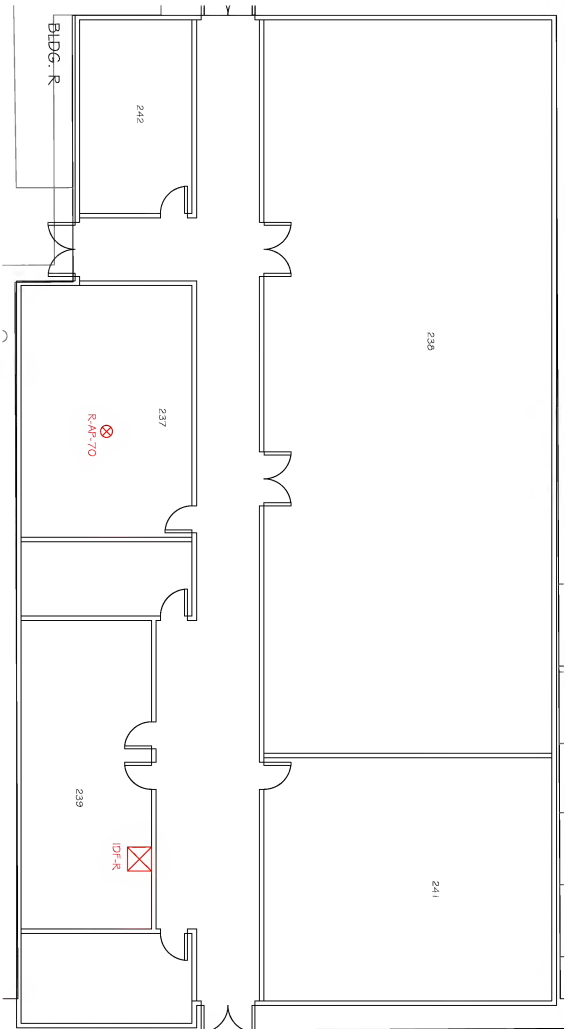

IDF-G - WIRELESS ACCESS POINT PLAN
SCALE: 3/32" = 1'-0"

LEGEND

❌ WIRELESS ACCESS POINT



PREPARED FOR:
**EL MONTE
UNION HIGH
SCHOOL
DISTRICT**


SITE:
**ROSEMEAD
HIGH SCHOOL**

1000 WILSON DRIVE
ROSEMEAD, CA 91770
AS BUILT
PROJECT NO. 5231

REV. NO.	DATE	DESCRIPTION

DRAWN BY:	DATE:
GERARDO MORALES	10/26/12
BY:	SCALE:
	AS SHOWN
SIZE:	11x17

TITLE:
IDF-G WIRELESS ACCESS POINT PLAN

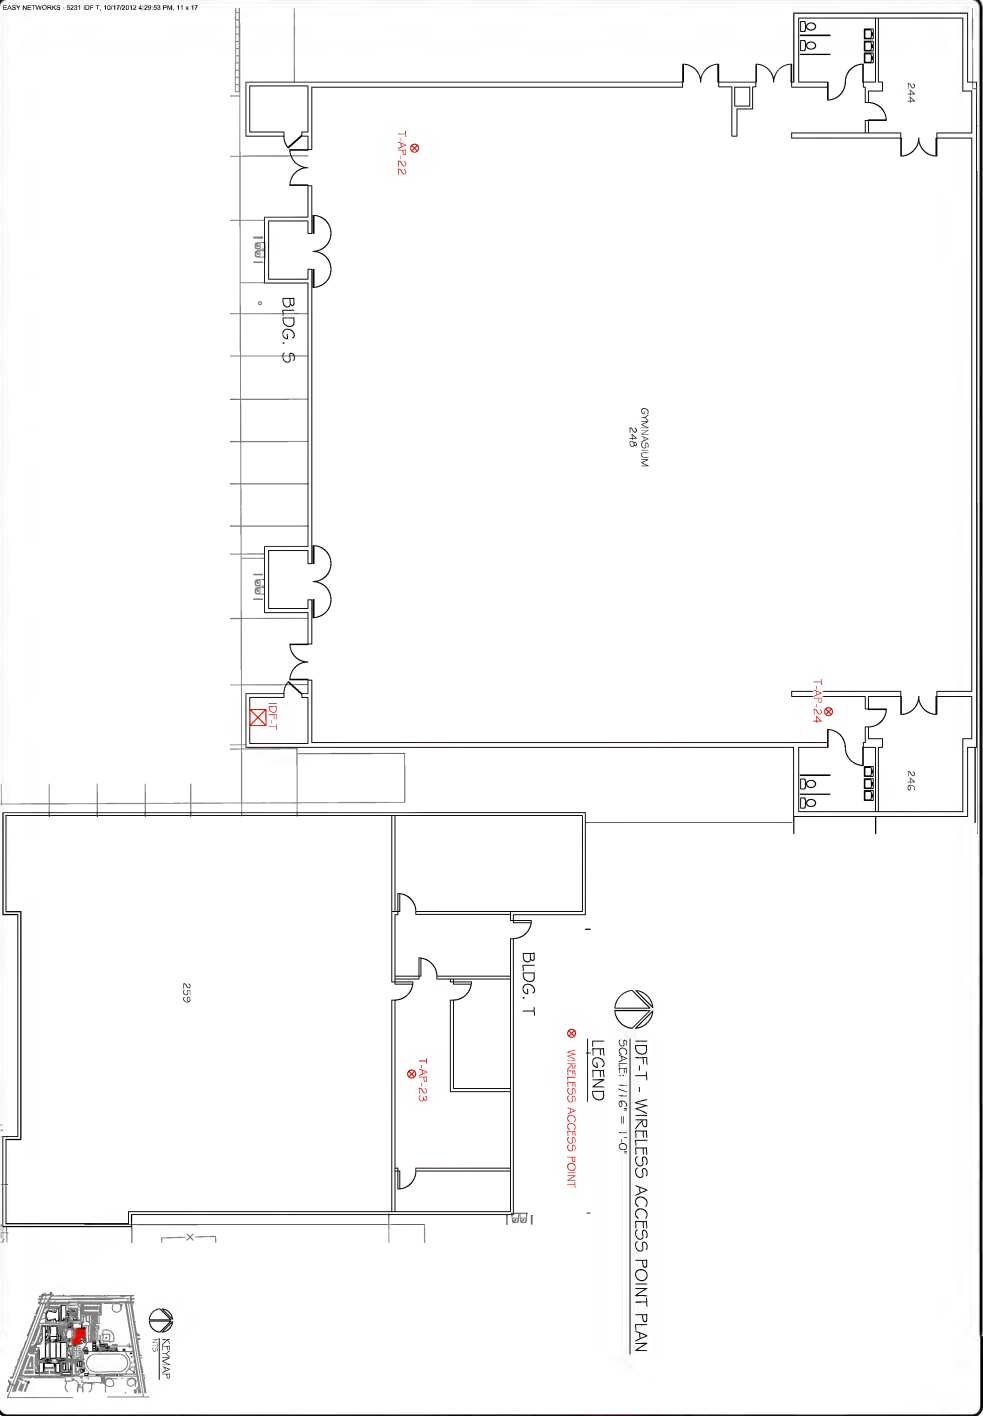

PREPARED FOR:
**EL MONTE
UNION HIGH
SCHOOL
DISTRICT**

SITE:
**ROSEMEAD
HIGH SCHOOL**

1000 MISSION DRIVE
ROSEMEAD, CA 91770
AS BUILT
PROJECT NO. 5231

NO.	REVISIONS:
DATE:	DESCRIPTION:

DRAWN BY:
GERARDO MORALES

DATE: 10/9/12

SCALE: AS SHOWN

SIZE: 11x17

TITLE: IDF-T
WIRELESS
ACCESS
POINT
PLAN

PREPARED FOR:
**EL MONTE
UNION HIGH
SCHOOL
DISTRICT**

SITE:
**SOUTH
EL MONTE
HIGH SCHOOL**

1001 N. DURFEE AVE.
EL MONTE, CA 91733

AS-BUILT
PROJECT NO. 5231

REVISIONS:
DATE DESCRIPTION:

DRAWN BY:
GERARDO MORALES

DATE: 10/9/12
SCALE: AS SHOWN
SIZE: 11 x 17


TITLE:
**WIRELESS ACCESS POINT
PLAN**

SHEET#:

T1

1 OF 14

AP #	Mac Address	Asset Tag	LOCATION
SEM-C-AP_20	002368931D58	40800	Bridge_1st_South_Room_C152, IDF-C
SEM-F-AP_21	002368930F08	40826	Food Service
SEM-A-AP_22	002368931D28	40824	Admin. Conference Office, IDF-A
SEM-L3-AP_23	002368930C2C	40832	MPP, South, IDF-L3
SEM-J-AP_24	0023689313A0	40835	Bridge_1st, IDF-J
SEM-D-AP_25	0023689307C7	40825	Bridge_1st_North_Room_D177, IDF-D
SEM-A-AP_26	0023689309A0	40827	Bridge_Vivint_Room_215, IDF-A
SEM-E-AP_27	0023689313AC	40831	Student Store, IDF-E
SEM-E-AP_28	0023689309C7	40835	Bridge_2nd_North_Room_1200, IDF-E
SEM-H-AP_29	002368930D9C	40817	PAC, IDF-H
SEM-H-AP_30	0023689310C0	40814	Bridge_Vivint_Room_215, IDF-H
SEM-MDF-AP_31	00236893111C	40819	Library_North, MDF
SEM-L-AP_33	0023689313AC	40822	Room_222, IDF-L
SEM-C-AP_34	002368930E28	40823	Bridge_1st_North_Room_C150, IDF-C
SEM-C-AP_35	0023689308D0	40820	Bridge_2nd_South_Room_C153, IDF-C
SEM-E-AP_36	002368930C4C	40816	Bridge_1st_South_Room_1193, IDF-E
SEM-E-AP_37	002368930D7A	40823	Bridge_1st_North_Room_6190, IDF-E
SEM-D-AP_38	00236893086C	40828	Bridge_1st_South_Room_D173, IDF-D
SEM-M-AP_39	002368930A4C	40829	Gym_Boys_Locker_Room_IDE-M
SEM-L2-AP_40	002368930B0D	36068	Kitchen, IDF-L2
SEM-D-AP_41	002368931004	36072	Bridge_2nd_South_Room_C155, IDF-D
SEM-L3-AP_42	002368931010	36064	MPP, North, IDF-L3
SEM-M-AP_43	0023689302B8	36063	Gym_2nd_Floor, IDF-M
SEM-MDF-AP_44	002368931064	36067	Library_South, MDF
SEM-P-AP_45	002368930A44	36070	Bridge_Vivint_Room_215, IDF-P
SEM-A-AP_46	00236893107D	36060	Bridge_Maintenance
SEM-M-AP_47	002368930C4C	36060	Gym_North, IDF-M
SEM-E-AP_48	002368930C78	36061	Bridge_2nd_North_Room_D187, IDF-D
SEM-L2-AP_49	002368930F08	36062	Teacher Lounge, IDF-L2
SEM-M-AP_50	002368930A0C	36066	Gym_Room_271, IDF-M
SEM-R-AP_51	002368930C18	36106	PAC, IDF-R
SEM-C-AP_53	0023689301D0	36074	2nd_North_Room_C160, IDF-C
SEM-A-AP_54	002368930A0C	36069	Admin. Guidance Office, IDF-A
SEM-E-AP_55	0023689310D4	36070	Bridge_2nd_South_Room_1203
SEM-P-AP_56	002368930410	36071	Room_213, Bridge, G
SEM-H-AP_57	002368930D04	36134	Bridge_2nd_North_Room_218, IDF-H
SEM-H-AP_58	002368930C2C	36108	Room_210, IDF-H
SEM-A-AP_59	002368930D1C	41015	Admin, IDF-A

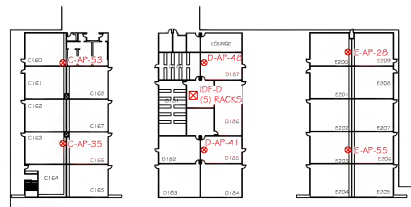

WIRELESS ACCESS POINT PLAN
SCALE: 1" = 20'-0"

LEGEND
● WIRELESS ACCESS POINT

PREPARED FOR:
**EL MONTE
UNION HIGH
SCHOOL
DISTRICT**

SITE:
**SOUTH
EL MONTE
HIGH SCHOOL**

1001 N. DURFEE AVE.
EL MONTE, CA 91733

**AS-BUILT
PROJECT NO. 5231**

REVISIONS:

DATE DESCRIPTION:

DRAWN BY:
GERARDO MORALES

DATE: 10/9/12
SCALE: AS SHOWN
SIZE: 11x17


TITLE:
**MDF
WIRELESS
ACCESS POINT
PLAN**

* PROPERTY OF EASY NETWORKS *
* NOT TO BE USED BY OTHERS WITHOUT PERMISSION *

SHEET #:

T2


2 OF 14

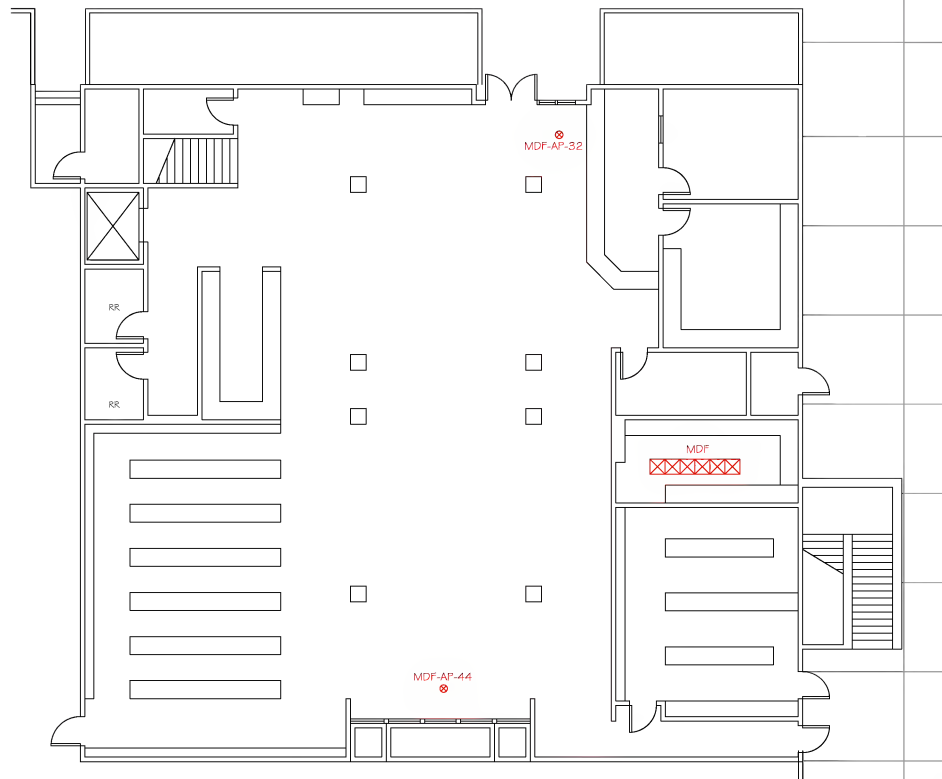

MDF - WIRELESS ACCESS POINT PLAN
SCALE: 3/32" = 1'-0"

LEGEND

● WIRELESS ACCESS POINT

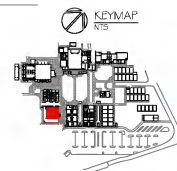

PREPARED FOR:
**EL MONTE
UNION HIGH
SCHOOL
DISTRICT**

SITE:
**SOUTH
EL MONTE
HIGH SCHOOL**

1001 N. DURFEE AVE.
EL MONTE, CA 91733

**AS-BUILT
PROJECT NO. 5231**

REVISIONS:

DATE DESCRIPTION

DRAWN BY:

GERARDO MORALES

DATE: 10/9/12

SCALE: AS SHOWN

SIZE: 11x17

TITLE:


**IDF-A
WIRELESS
ACCESS POINT
PLAN**

* PROPERTY OF EASY NETWORKS *
* NOT TO BE USED FOR REPRODUCTION *

SHEET #:

T3

3 OF 14

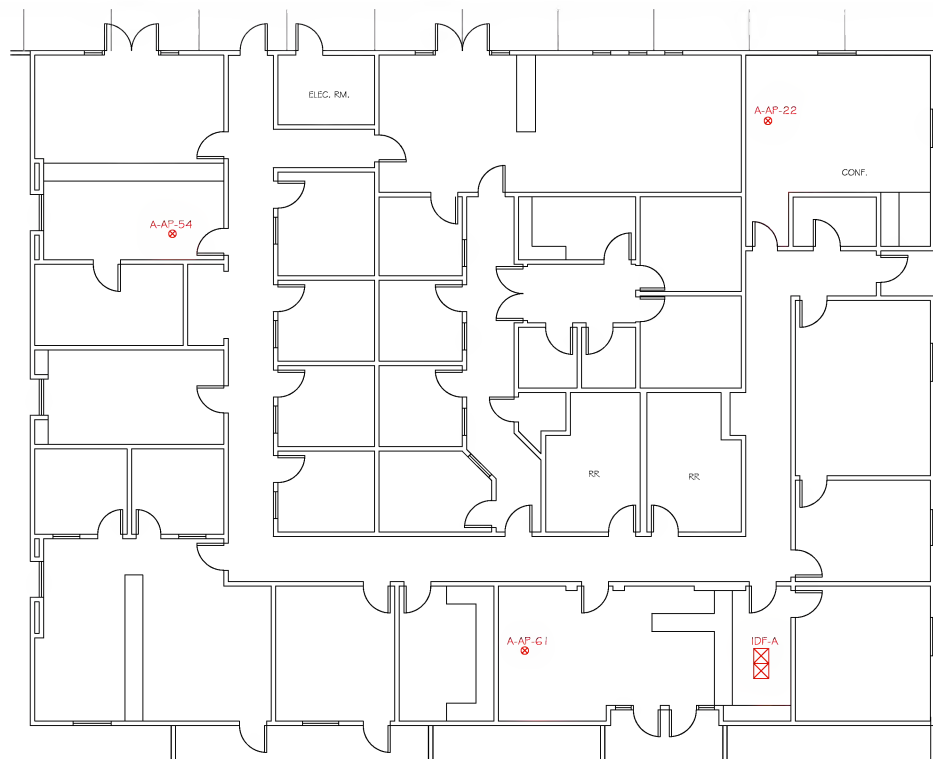

IDF-A - WIRELESS ACCESS POINT PLAN
SCALE: 3/32" = 1'-0"

LEGEND

WIRELESS ACCESS POINT



PREPARED FOR:
**EL MONTE
UNION HIGH
SCHOOL
DISTRICT**

SITE:
**SOUTH
EL MONTE
HIGH SCHOOL**

1001 N. DURFEE AVE.
EL MONTE, CA 91733

**AS-BUILT
PROJECT NO. 5231**

REVISIONS:

DATE: **DESCRIPTION:**

DRAWN BY:

GERARDO MORALES

DATE:

10/9/12

SCALE:

AS SHOWN

SIZE:

11x17

TITLE:


**IDF-C
WIRELESS
ACCESS POINT
PLAN**

PROPERTY OF EAST NETWORKS
NOT TO BE USED FOR REPRODUCTION


SHEET #:

T4

4 OF 14

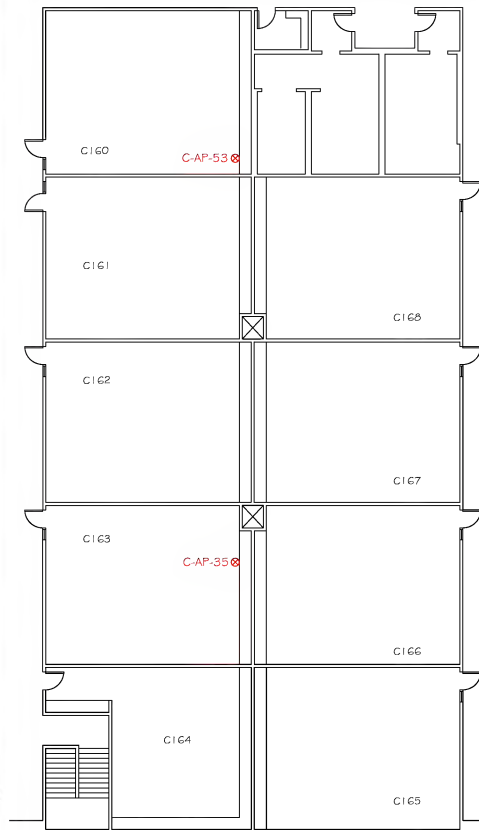

**BUILDING C
SECOND FLOOR**

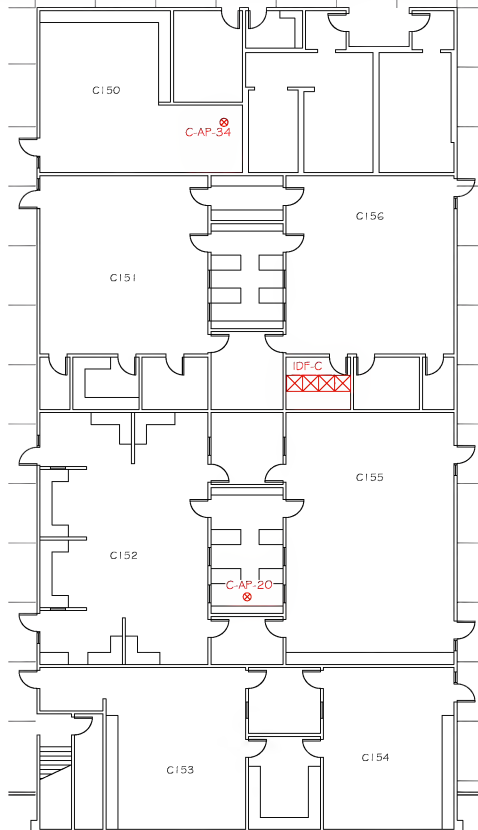


**BUILDING C
FIRST FLOOR**



IDF-C - WIRELESS ACCESS POINT PLAN
SCALE: 1/16" = 1'-0"

LEGEND

WIRELESS ACCESS POINT

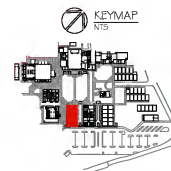

PREPARED FOR:
**EL MONTE
UNION HIGH
SCHOOL
DISTRICT**

SITE:
**SOUTH
EL MONTE
HIGH SCHOOL**

1001 N. DURFEE AVE.
EL MONTE, CA 91733


**AS-BUILT
PROJECT NO. 5231**




IDF-D - WIRELESS ACCESS POINT PLAN
SCALE: 1/16" = 1'-0"

LEGEND


⊗ WIRELESS ACCESS POINT

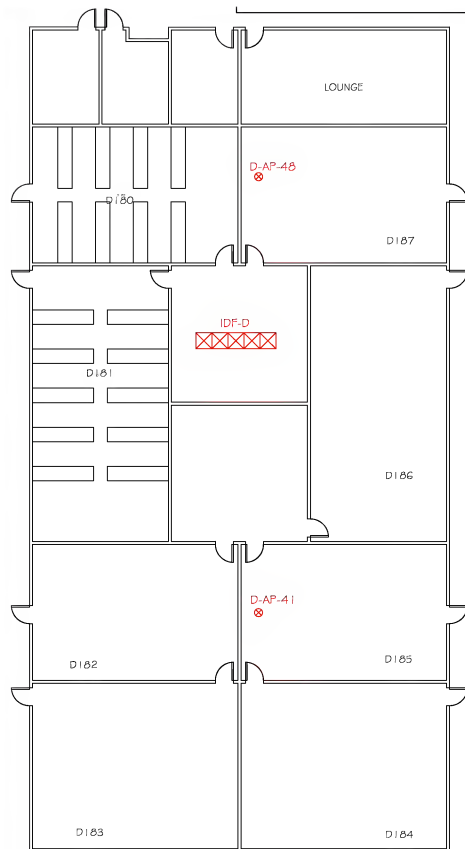

**BUILDING D
SECOND FLOOR**

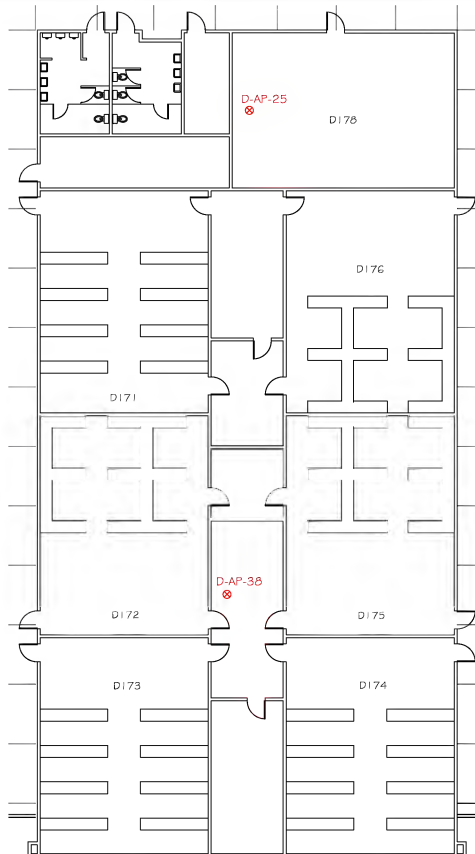

**BUILDING D
FIRST FLOOR**

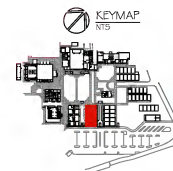

REVISIONS:

DATE	DESCRIPTION

DRAWN BY:

GERARDO MORALES

DATE:

10/9/12

SCALE:

AS SHOWN

SIZE:

11x17

TITLE:

IDF-D

WIRELESS

ACCESS POINT

PLAN

PROPERTY OF EASY NETWORKS

DO NOT USE FOR ANY OTHER PROJECTS

SHEET #:

T5

5 OF 14

PREPARED FOR:
**EL MONTE
UNION HIGH
SCHOOL
DISTRICT**

SITE:
**SOUTH
EL MONTE
HIGH SCHOOL**

1001 N. DURFEE AVE.
EL MONTE, CA 91733

AS-BUILT
PROJECT NO. 5231

REVISIONS:

DATE: **DESCRIPTION:**

DRAWN BY:

GERARDO MORALES

DATE: 10/9/12

SCALE: AS SHOWN

SIZE: 11x17

TITLE:


**IDF-E
WIRELESS
ACCESS POINT
PLAN**

* PROPERTY OF EASY NETWORKS *
* NOT TO BE USED FOR REPRODUCTION *



SHEET #:

T6

6 OF 14

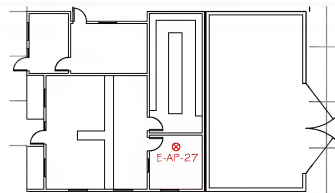

IDF-E

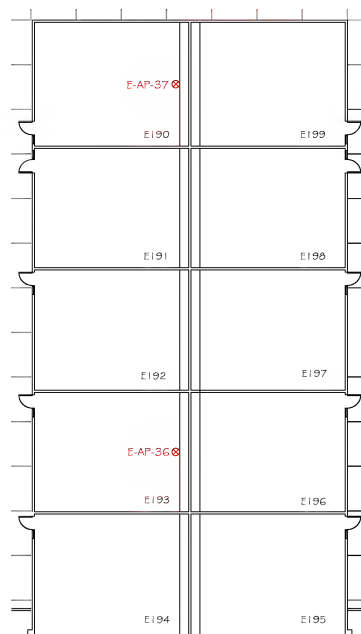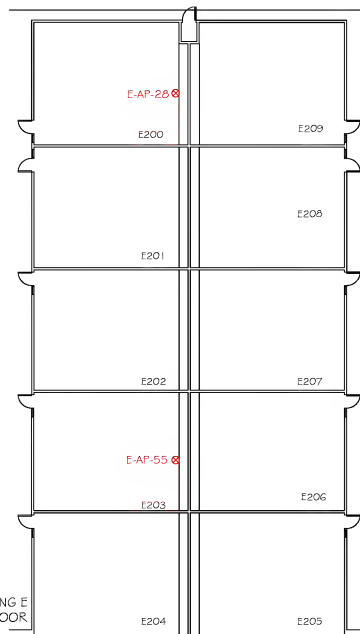

IDF-E - WIRELESS ACCESS POINT PLAN
SCALE: 3/64" = 1'-0"

LEGEND

⊗ WIRELESS ACCESS POINT



BUILDING E
SECOND FLOOR

BUILDING E
FIRST FLOOR

PREPARED FOR:
**EL MONTE
UNION HIGH
SCHOOL
DISTRICT**

SITE:
**SOUTH
EL MONTE
HIGH SCHOOL**

1001 N. DURFEE AVE.
EL MONTE, CA 91733

**AS-BUILT
PROJECT NO. 5231**

REVISIONS:

DATE	DESCRIPTION

DRAWN BY:

GERARDO MORALES

DATE:

10/9/12

SCALE:

AS SHOWN

SIZE:

11 x 17

TITLE:

**IDF-F
WIRELESS
ACCESS POINT
PLAN**

• PROPERTY OF EASY NETWORKS •
• NOT TO BE USED BY ANY OTHER PARTY •

SHEET#:

T7

7 OF 14



IDF-F - WIRELESS ACCESS POINT PLAN
SCALE: 1/16" = 1'-0"

LEGEND

• WIRELESS ACCESS POINT



PREPARED FOR:
**EL MONTE
UNION HIGH
SCHOOL
DISTRICT**

SITE:
**SOUTH
EL MONTE
HIGH SCHOOL**

1001 N. DURFEE AVE.
EL MONTE, CA 91733

**AS-BUILT
PROJECT NO. 5231**

REVISIONS:

DATE	DESCRIPTION

DRAWN BY:

GERARDO MORALES

DATE:

10/9/12

SCALE:

AS SHOWN

SIZE:

11x17

TITLE:


**IDF-H
WIRELESS
ACCESS POINT
PLAN**

*PROPERTY OF EASY NETWORKS
*NOT TO BE USED BY EASY NETWORKS ONLY

SHEET #:

T8

8 OF 14

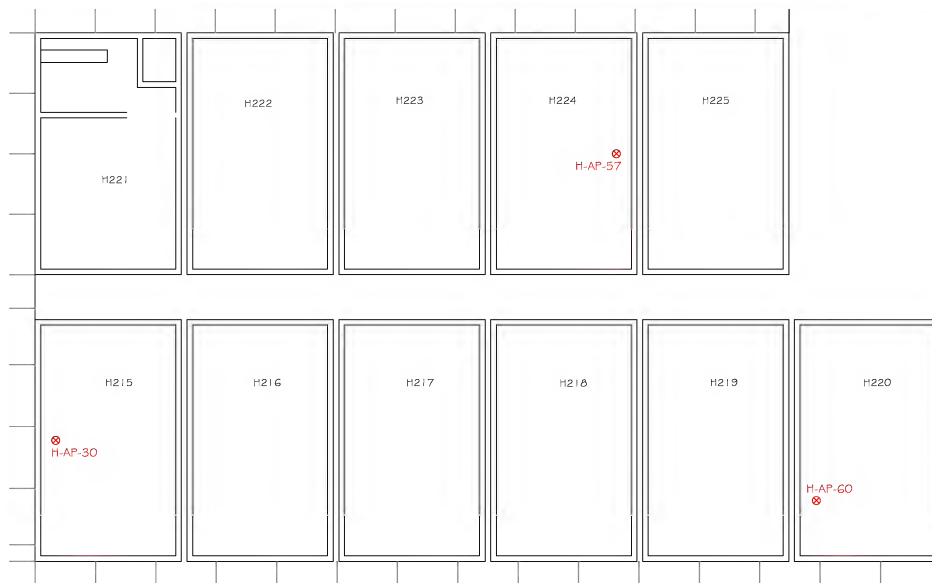


IDF-H - WIRELESS ACCESS POINT PLAN

SCALE: 1/16" = 1'-0"

LEGEND

⊗ WIRELESS ACCESS POINT

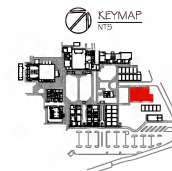

PREPARED FOR:
**EL MONTE
UNION HIGH
SCHOOL
DISTRICT**

SITE:
**SOUTH
EL MONTE
HIGH SCHOOL**

1001 N. DURFEE AVE.
EL MONTE, CA 91733

**AS-BUILT
PROJECT NO. 5231**

REVISIONS:

DATE	DESCRIPTION

DRAWN BY:

GERARDO MORALES

DATE:

10/9/12

SCALE:

AS SHOWN

SIZE:

11x17

TITLE:

**IDF-J
WIRELESS
ACCESS POINT
PLAN**

• PROPERTY OF EASY NETWORKS •
• NOT TO BE USED BY EASY NETWORKS ONLY •

SHEET #:

T9

9 OF 14



IDF-J - WIRELESS ACCESS POINT PLAN


SCALE: 1/16" = 1'-0"

LEGEND

⊗ WIRELESS ACCESS POINT

M216

H-AP-60

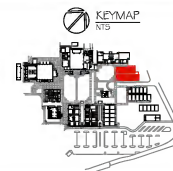


PREPARED FOR:
**EL MONTE
UNION HIGH
SCHOOL
DISTRICT**

SITE:
**SOUTH
EL MONTE
HIGH SCHOOL**

1001 N. DURFEE AVE.
EL MONTE, CA 91733

**AS-BUILT
PROJECT NO. 5231**

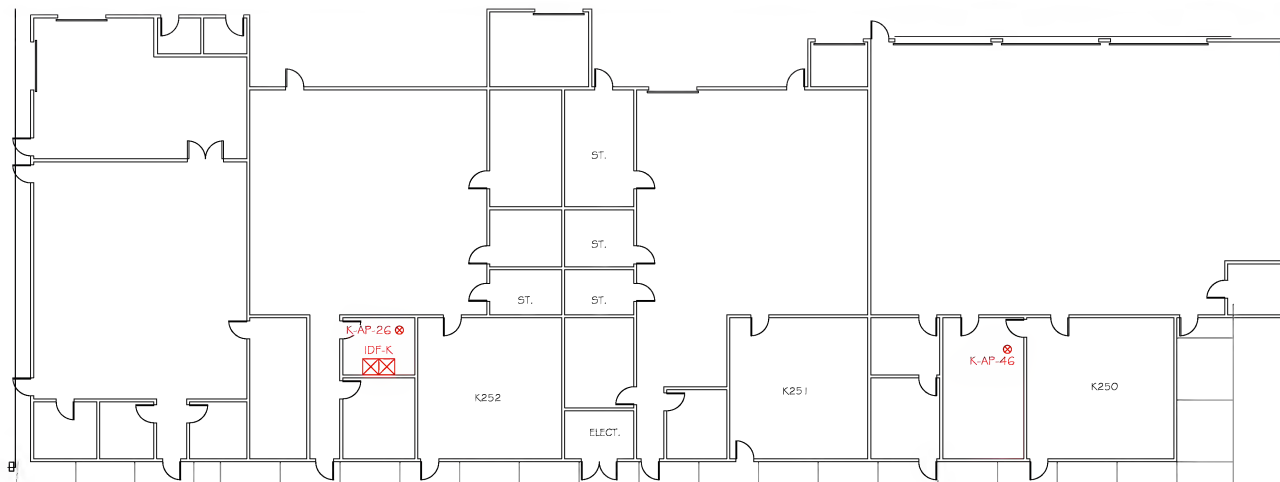

IDF-K - WIRELESS ACCESS POINT PLAN

SCALE: 1/16" = 1'-0"

LEGEND

⊗ WIRELESS ACCESS POINT

REVISIONS:

Δ DATE DESCRIPTION

DRAWN BY:

GERARDO MORALES

DATE:

10/9/12

SCALE:

AS SHOWN

SIZE:

11x17

TITLE:


**IDF-K
WIRELESS
ACCESS POINT
PLAN**

PROPERTY OF EASY NETWORKS
NOT TO BE USED BY ANY OTHER PARTY

SHEET #:

T10

10 OF 14

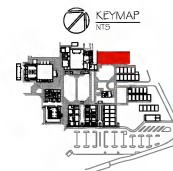

PREPARED FOR:
**EL MONTE
UNION HIGH
SCHOOL
DISTRICT**

SITE:
**SOUTH
EL MONTE
HIGH SCHOOL**

1001 N. DURFEE AVE.
EL MONTE, CA 91733

**AS-BUILT
PROJECT NO. 5231**

REVISIONS:

DATE DESCRIPTION

DRAWN BY:

GERARDO MORALES

DATE: 10/9/12

SCALE: AS SHOWN

SIZE: 11x17

TITLE:


**IDF-L1 & L2
WIRELESS
ACCESS POINT
PLAN**

PROPERTY OF EASY NETWORKS
NOT TO BE USED FOR REPRODUCTION

SHEET#:

T11

11 OF 14

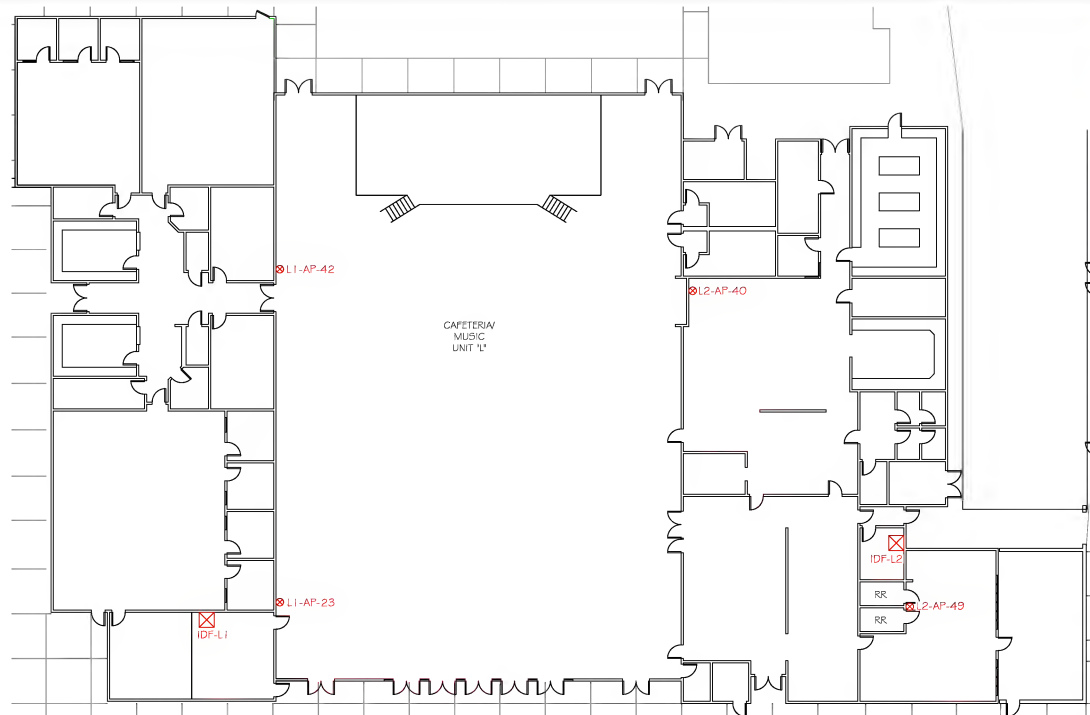


IDF-L1 & L2 - WIRELESS ACCESS POINT PLAN

SCALE: 1/16" = 1'-0"

LEGEND

X WIRELESS ACCESS POINT

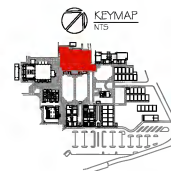

PREPARED FOR:
**EL MONTE
UNION HIGH
SCHOOL
DISTRICT**

SITE:
**SOUTH
EL MONTE
HIGH SCHOOL**

1001 N. DURFEE AVE.
EL MONTE, CA 91733

**AS-BUILT
PROJECT NO. 5231**

REVISIONS:

DATE DESCRIPTION

DRAWN BY:

GERARDO MORALES

DATE:

10/9/12

SCALE:

AS SHOWN

SIZE:

11x17

TITLE:


**IDF-M
WIRELESS
ACCESS POINT
PLAN**

* PROPERTY OF EASY NETWORKS *
* FOR USE BY EASY NETWORKS ONLY *


SHEET#:

T12

12 OF 14

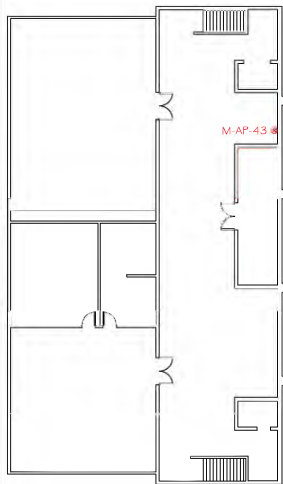

SECOND FLOOR

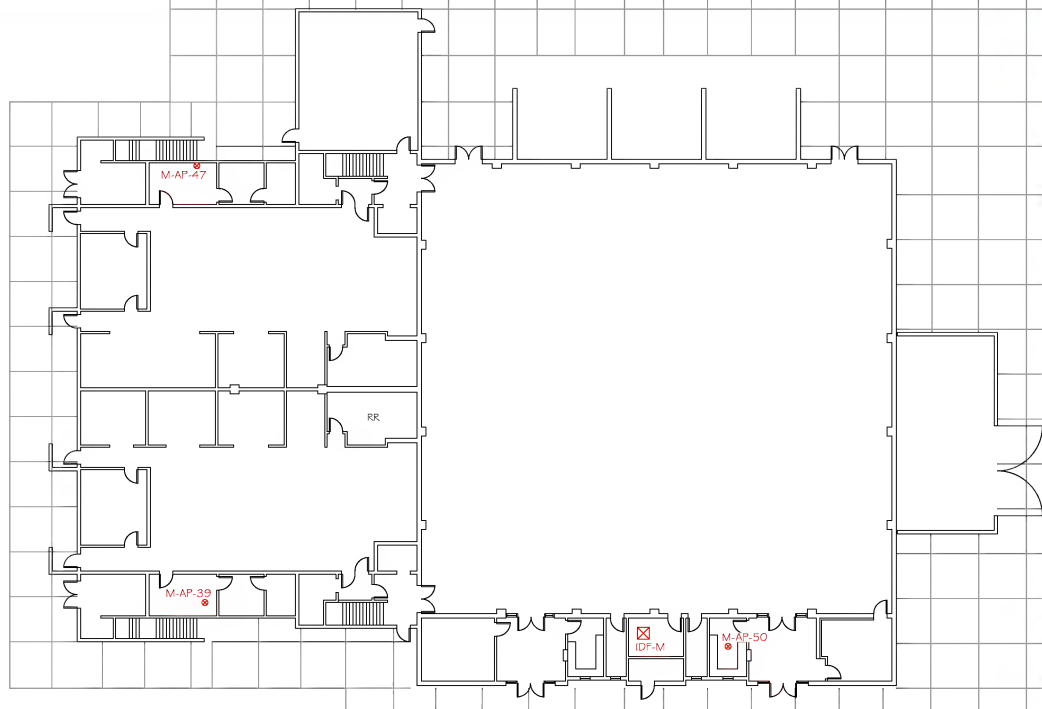


IDF-M - WIRELESS ACCESS POINT PLAN

SCALE: 1/16" = 1'-0"

LEGEND

⊗ WIRELESS ACCESS POINT

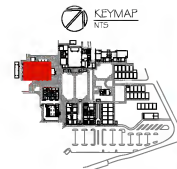

PREPARED FOR:
**EL MONTE
UNION HIGH
SCHOOL
DISTRICT**

SITE:
**SOUTH
EL MONTE
HIGH SCHOOL**

1001 N. DURFEE AVE.
EL MONTE, CA 91733

**AS-BUILT
PROJECT NO. 5231**

REVISIONS:

DATE: **DESCRIPTION:**

DRAWN BY:

GERARDO MORALES

DATE: 10/9/12

SCALE: AS SHOWN

SIZE: 11x17

TITLE:


**IDF-N
WIRELESS
ACCESS POINT
PLAN**

* PROPERTY OF EASY NETWORKS *
* NOT TO BE USED BY ANY OTHER FIRM OR INDIVIDUAL *

SHEET #:

T13

13 OF 14

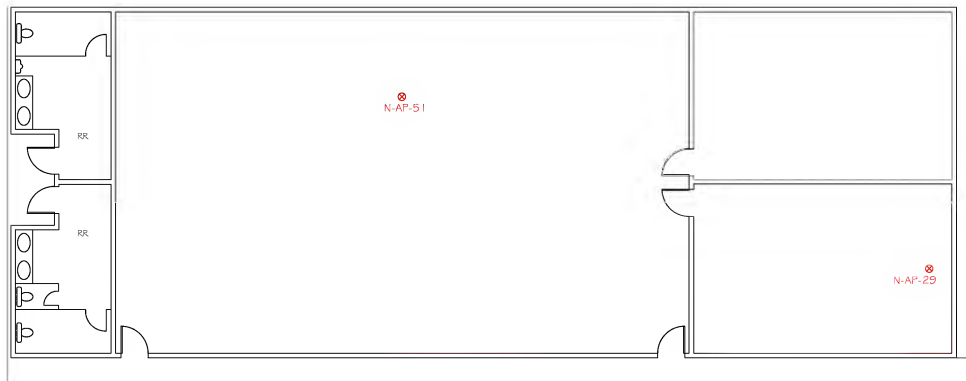


IDF-N - WIRELESS ACCESS POINT PLAN

SCALE: 3/32" = 1'-0"

LEGEND

 WIRELESS ACCESS POINT

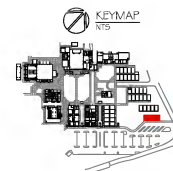

PREPARED FOR:
**EL MONTE
UNION HIGH
SCHOOL
DISTRICT**

SITE:
**SOUTH
EL MONTE
HIGH SCHOOL**

1001 N. DURFEE AVE.
EL MONTE, CA 91733

AS-BUILT
PROJECT NO. 5231

REVISIONS:

DATE	DESCRIPTION

DRAWN BY:

GERARDO MORALES

DATE:

10/9/12

SCALE:

AS SHOWN

SIZE:

11x17

TITLE:


**IDF-N
WIRELESS
ACCESS POINT
PLAN**

PROPERTY OF EASY NETWORKS
NOT TO BE USED BY ANY OTHER PERSON OR FIRM

SHEET#:

T14

14 OF 14

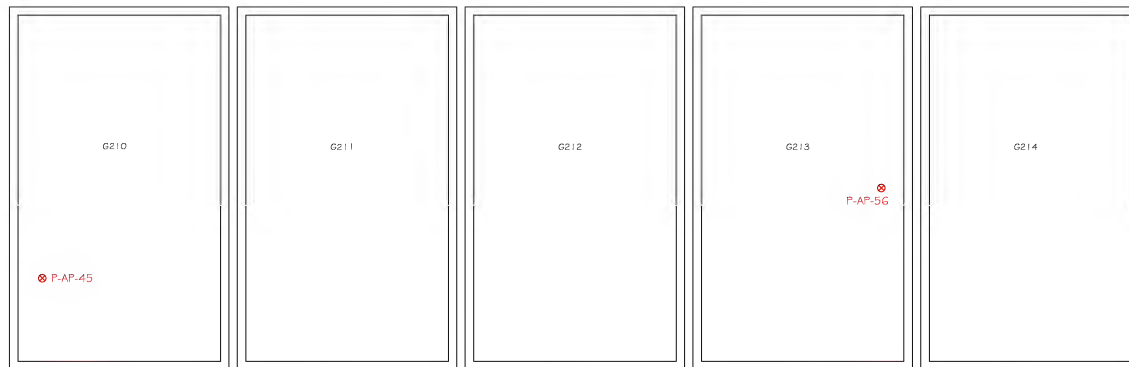


IDF-P - WIRELESS ACCESS POINT PLAN

SCALE: 3/32" = 1'-0"

LEGEND

 **WIRELESS ACCESS POINT**

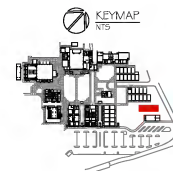

AP #	NAME	LOCATION
WMS-AP-31	002280908C	Building Warehouse
WMS-AP-52	002280908C	Warehouse
WMS-AP-58	002280908C	New Warehouse Maintenance Breakroom



SECOND FLOOR - WIRELESS ACCESS POINT PLAN
SCALE: 1/32" = 1'-0"



FIRST FLOOR - WIRELESS ACCESS POINT PLAN
SCALE: 1/32" = 1'-0"

LEGEND

PREPARED FOR
EL MONTE
UNION HIGH
SCHOOL
DISTRICT

SITE
MAINTENANCE
FACILITIES

1800 N. DUFFEE AVE
EL MONTE, CA 91733

AS-BUILT
PROJECT NO.: 5231

REVISIONS:
DATE: DESCRIPTION:

DRAWN BY:
GERARDO MORALES

DATE: 10/25/12
BY: AS 51147
SCALE: 1/16"

TITLE:
WIRELESS
ACCESS POINT
PLAN

SHEET:
T 1
1 OF 1

EASYNETWORKS
CABLING
1000 N. DUFFEE AVE
EL MONTE, CA 91733
TEL: 626-286-8888
FAX: 626-286-8889